

A1	INDEX	DATE	REVISIONS	DRAWN	CHECKED	PASSED
	A	30/05/2024	Builder's Issue			

DRAWN	CH	23.05.2024
CHECKED	CU	29.05.2024
PASSED		
INITIALS	DATE	

saunders havill group
 Brisbane Springfield
 head office 9 Thompson St Bowen Hills Q 4006
 phone 1900 123 SHS web www.saundershavill.com
 Drawing No: 9112 S 57 AC A




IPSWICH CITY COUNCIL

AS CONSTRUCTED - DRAINAGE
 EDEN'S CROSSING - STAGE 16
 PADEMELON STREET, REDBANK PLAINS


SCALE	1:250
SHEET	1 OF 2 SHEETS
DRAWING NO.	

* The SL is not final.

300x300 Subsurface Drainage Pit

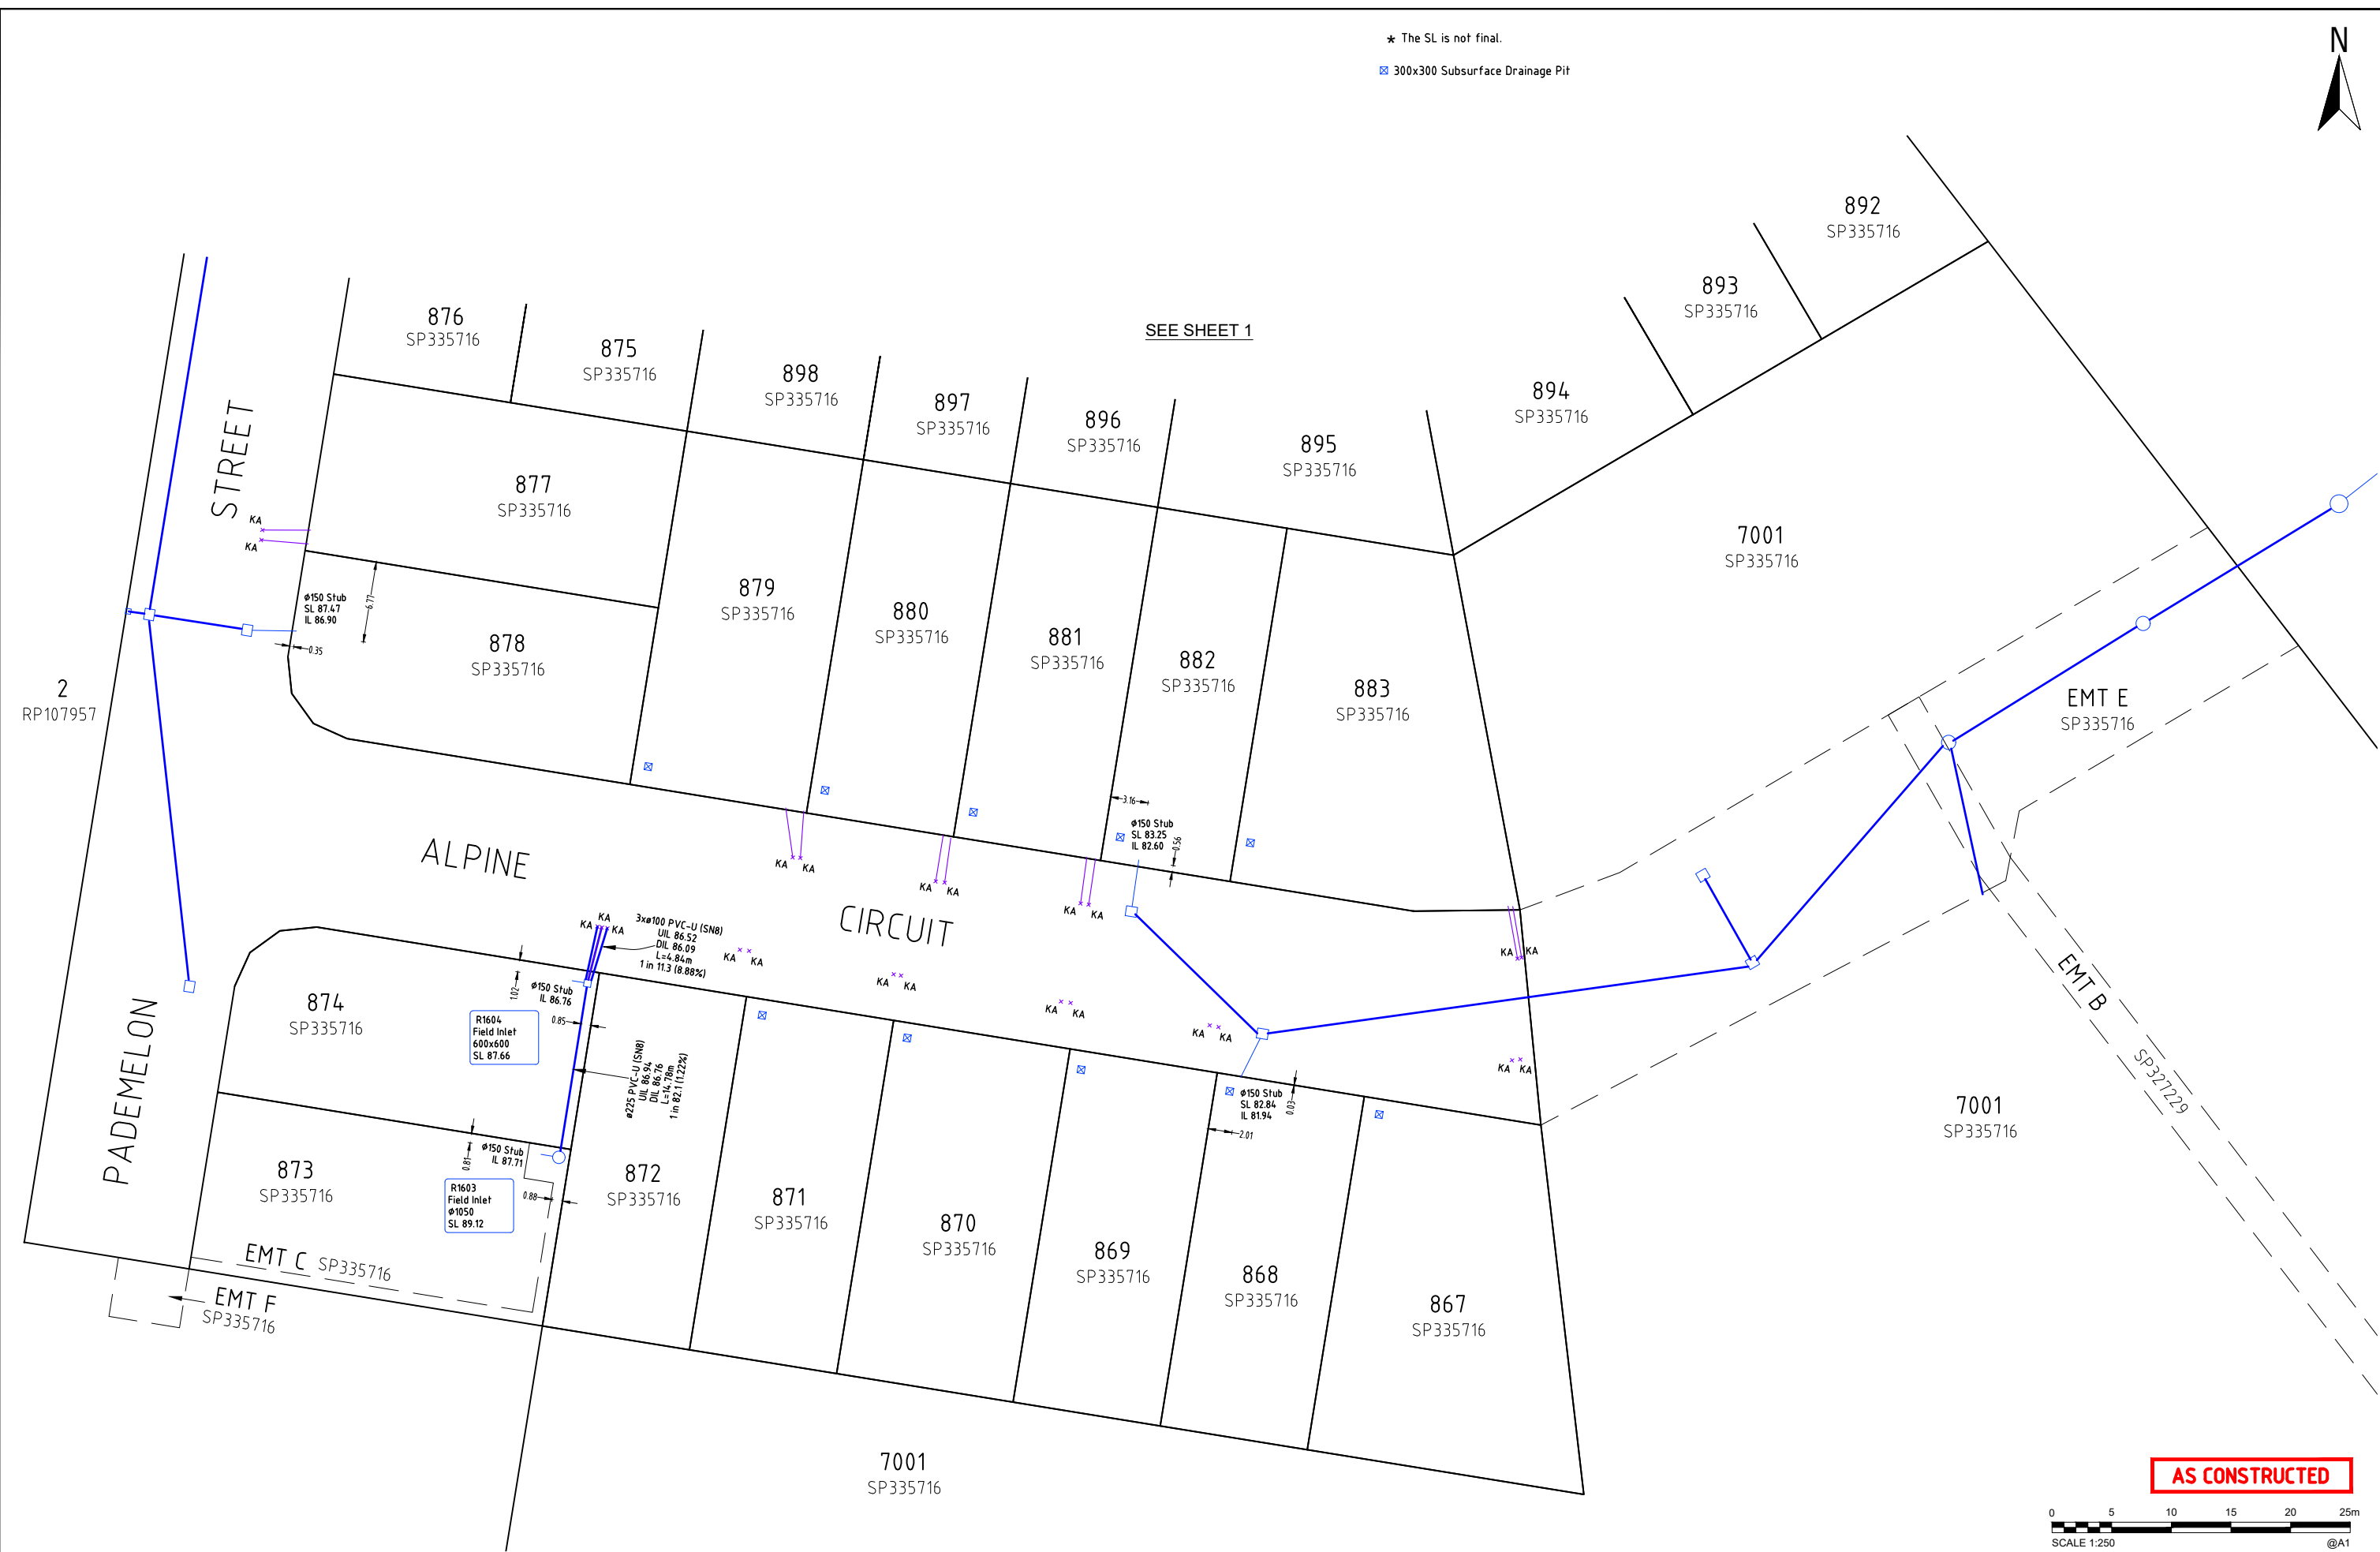

AS CONSTRUCTED

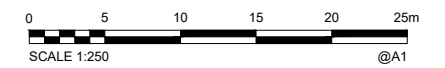

A1	INDEX	DATE	REVISIONS	DRAWN	CHECKED	PASSED
	A	30/05/2024	Builder's Issue			


DRAWN	CM	23.05.2024
CHECKED	CU	29.05.2024
PASSED		
INITIALS	DATE	

SH saunders havill group
 Brisbane Springfield
 head office 9 Thompson St Bowen Hills Q 4006
 phone 1800 123 SHS web www.saundershavill.com
 Drawing No: 9112 S 57 AC A



IPSWICH CITY COUNCIL
 AS CONSTRUCTED - DRAINAGE
 EDEN'S CROSSING - STAGE 16
 PADMELON STREET, REDBANK PLAINS

SCALE	1:250
SHEET	2 OF 2 SHEETS
DRAWING NO.	

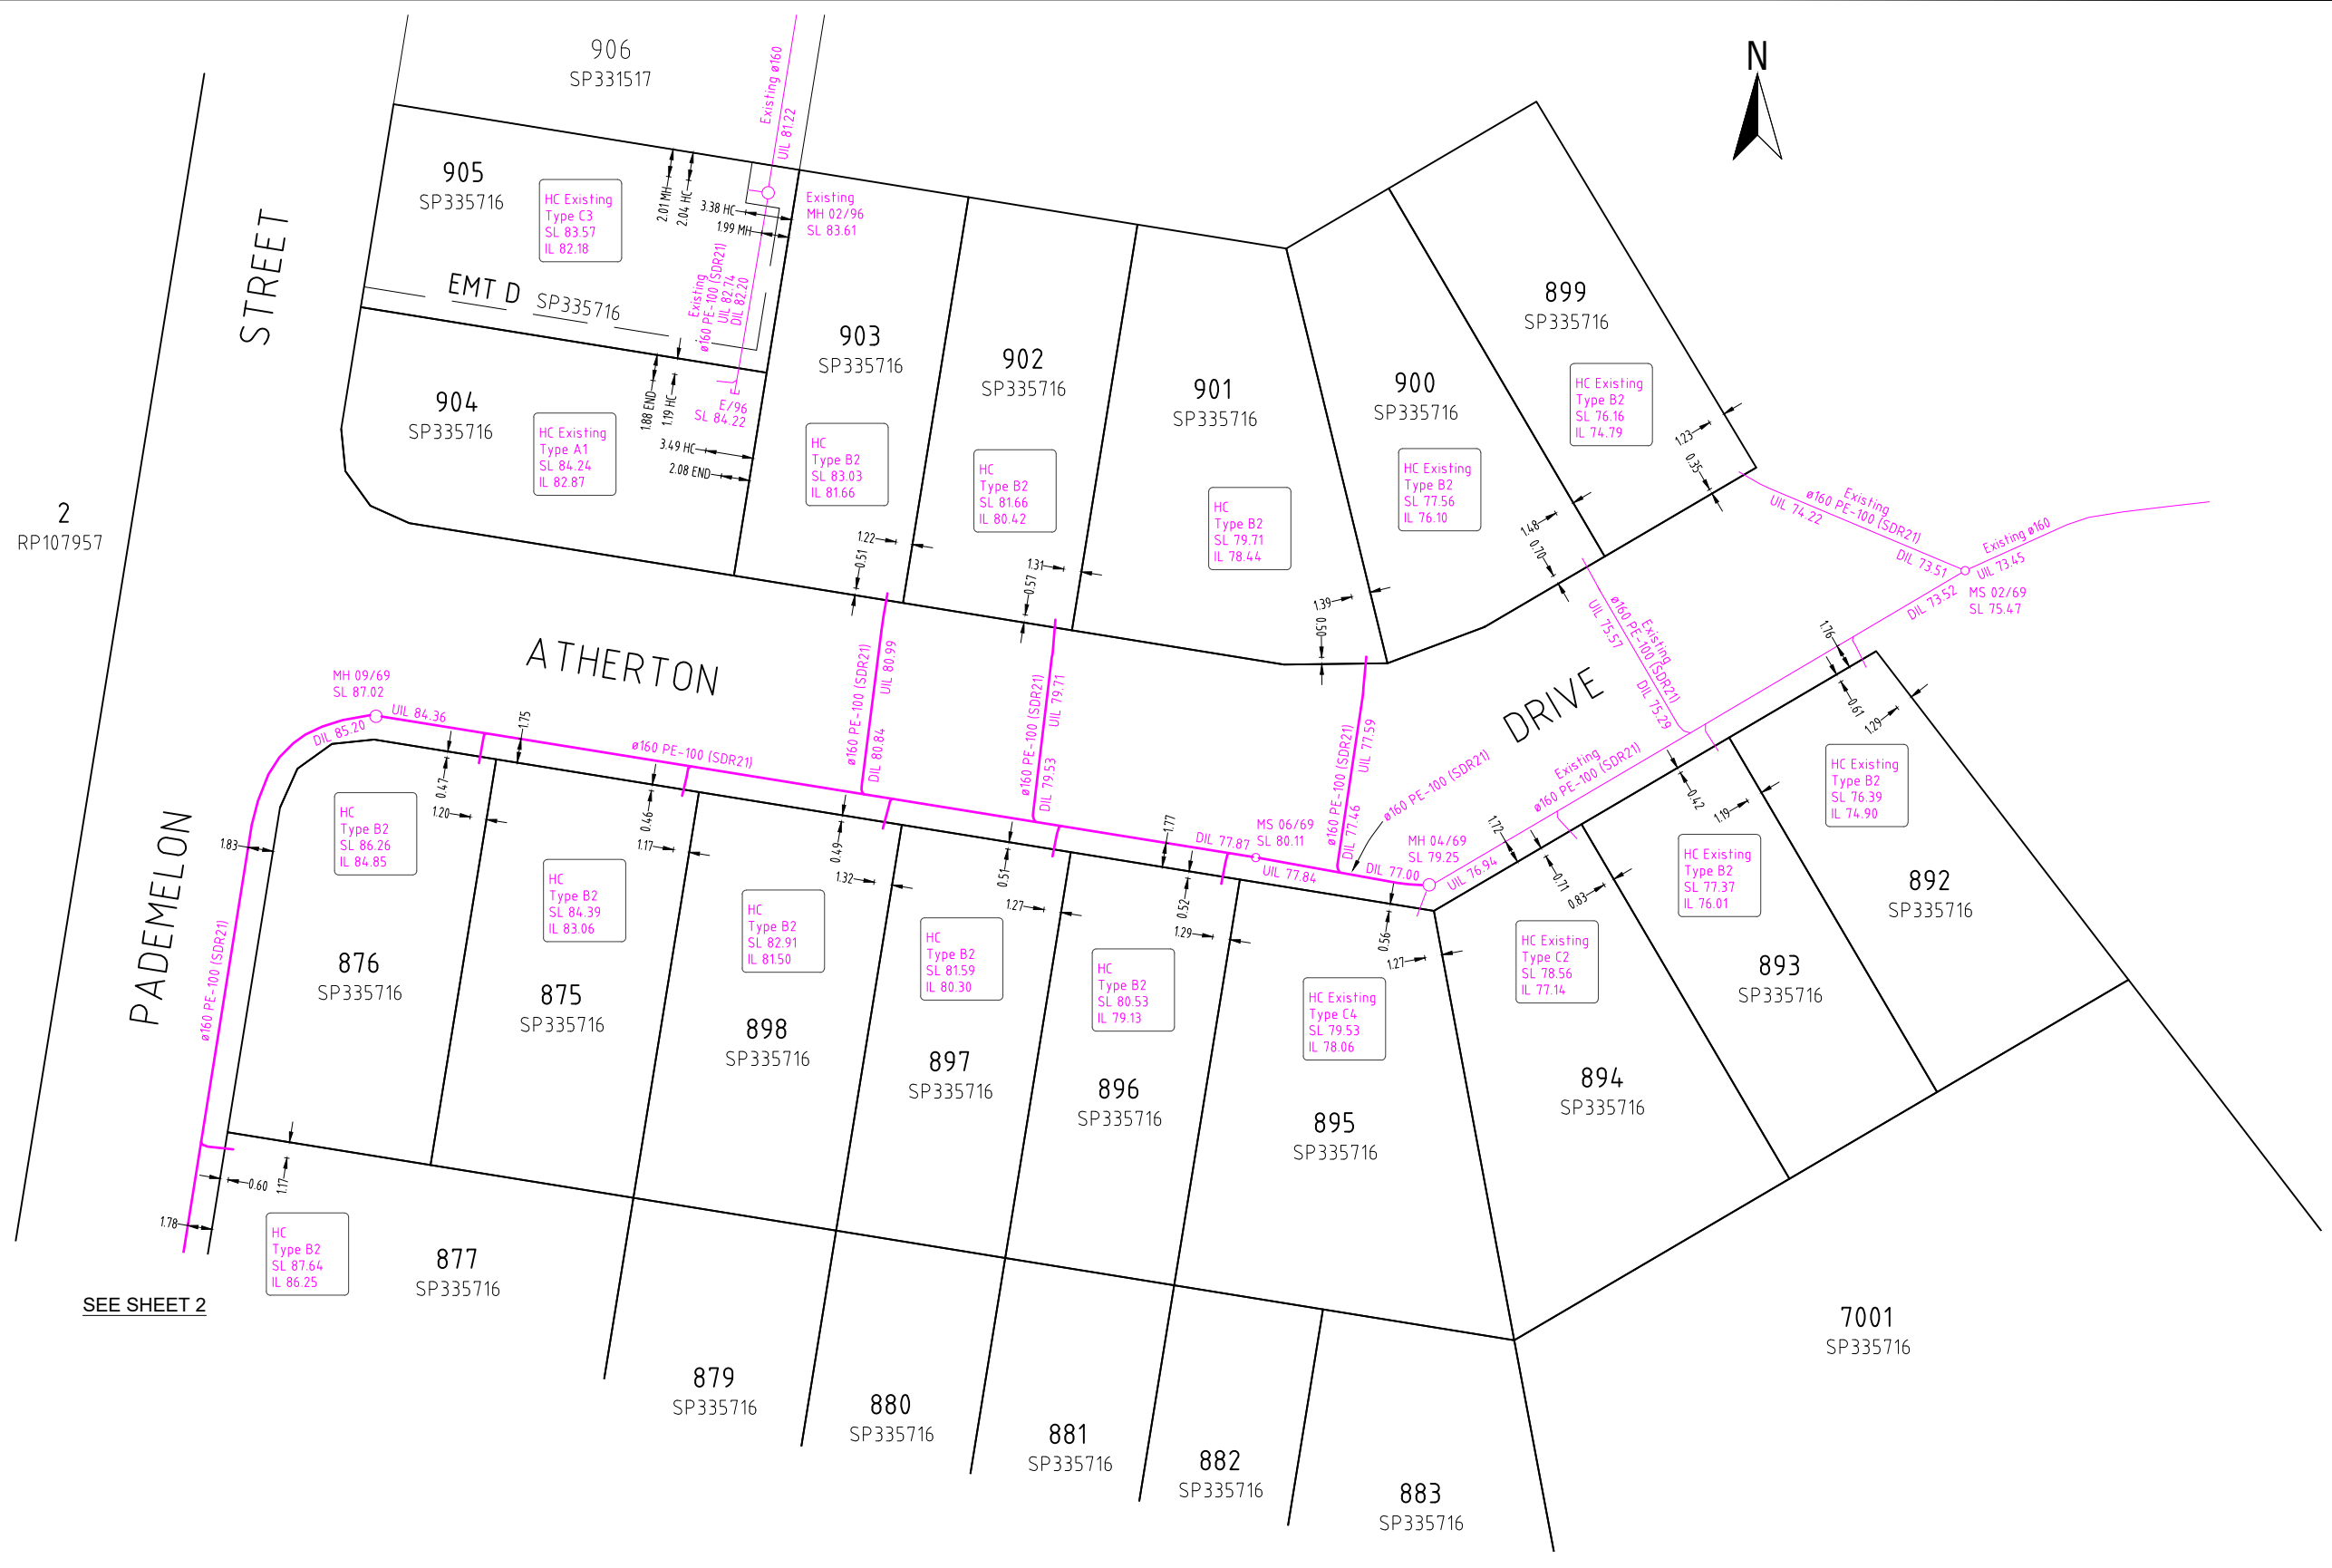


2
RP107957

SEE SHEET 2

SEE SHEET 2

All house connections are ϕ 110 unless otherwise noted.

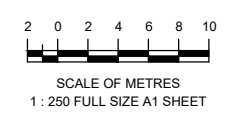

A1

REV NO	DATE	REVISION PURPOSE / DESCRIPTION	DRAWN	RPEQ	RPEQ No
A	30.05.2024	Builders Issue			

DRAWN	CM	15.05.2024
CHECKED	CU	16.05.2024
APPROVED		


SH saunders havill group
 Saunders Havill Group Pty Ltd ABN 24 144 592 949
 head office 5 Thompson St Bowen Hills Q 4006
 phone: 1800 423 SHG web: www.saundershavill.com
 ■ surveying ■ town planning ■ urban design ■ environmental management ■ landscape architecture
 Drawing No: 9112 S 56 AC A



EDEN'S CROSSING - STAGE 16
SUNBIRD DRIVE, REDBANK PLAINS
PLAN OF ADAC SURVEY DATA
SEWERAGE RETICULATION 22-PNT-56638

DRAWING STATUS AS CONSTRUCTED	
SHEET 1 OF 2 SHEETS	
DRAWING NO.	REV.
	A

SEE SHEET 1

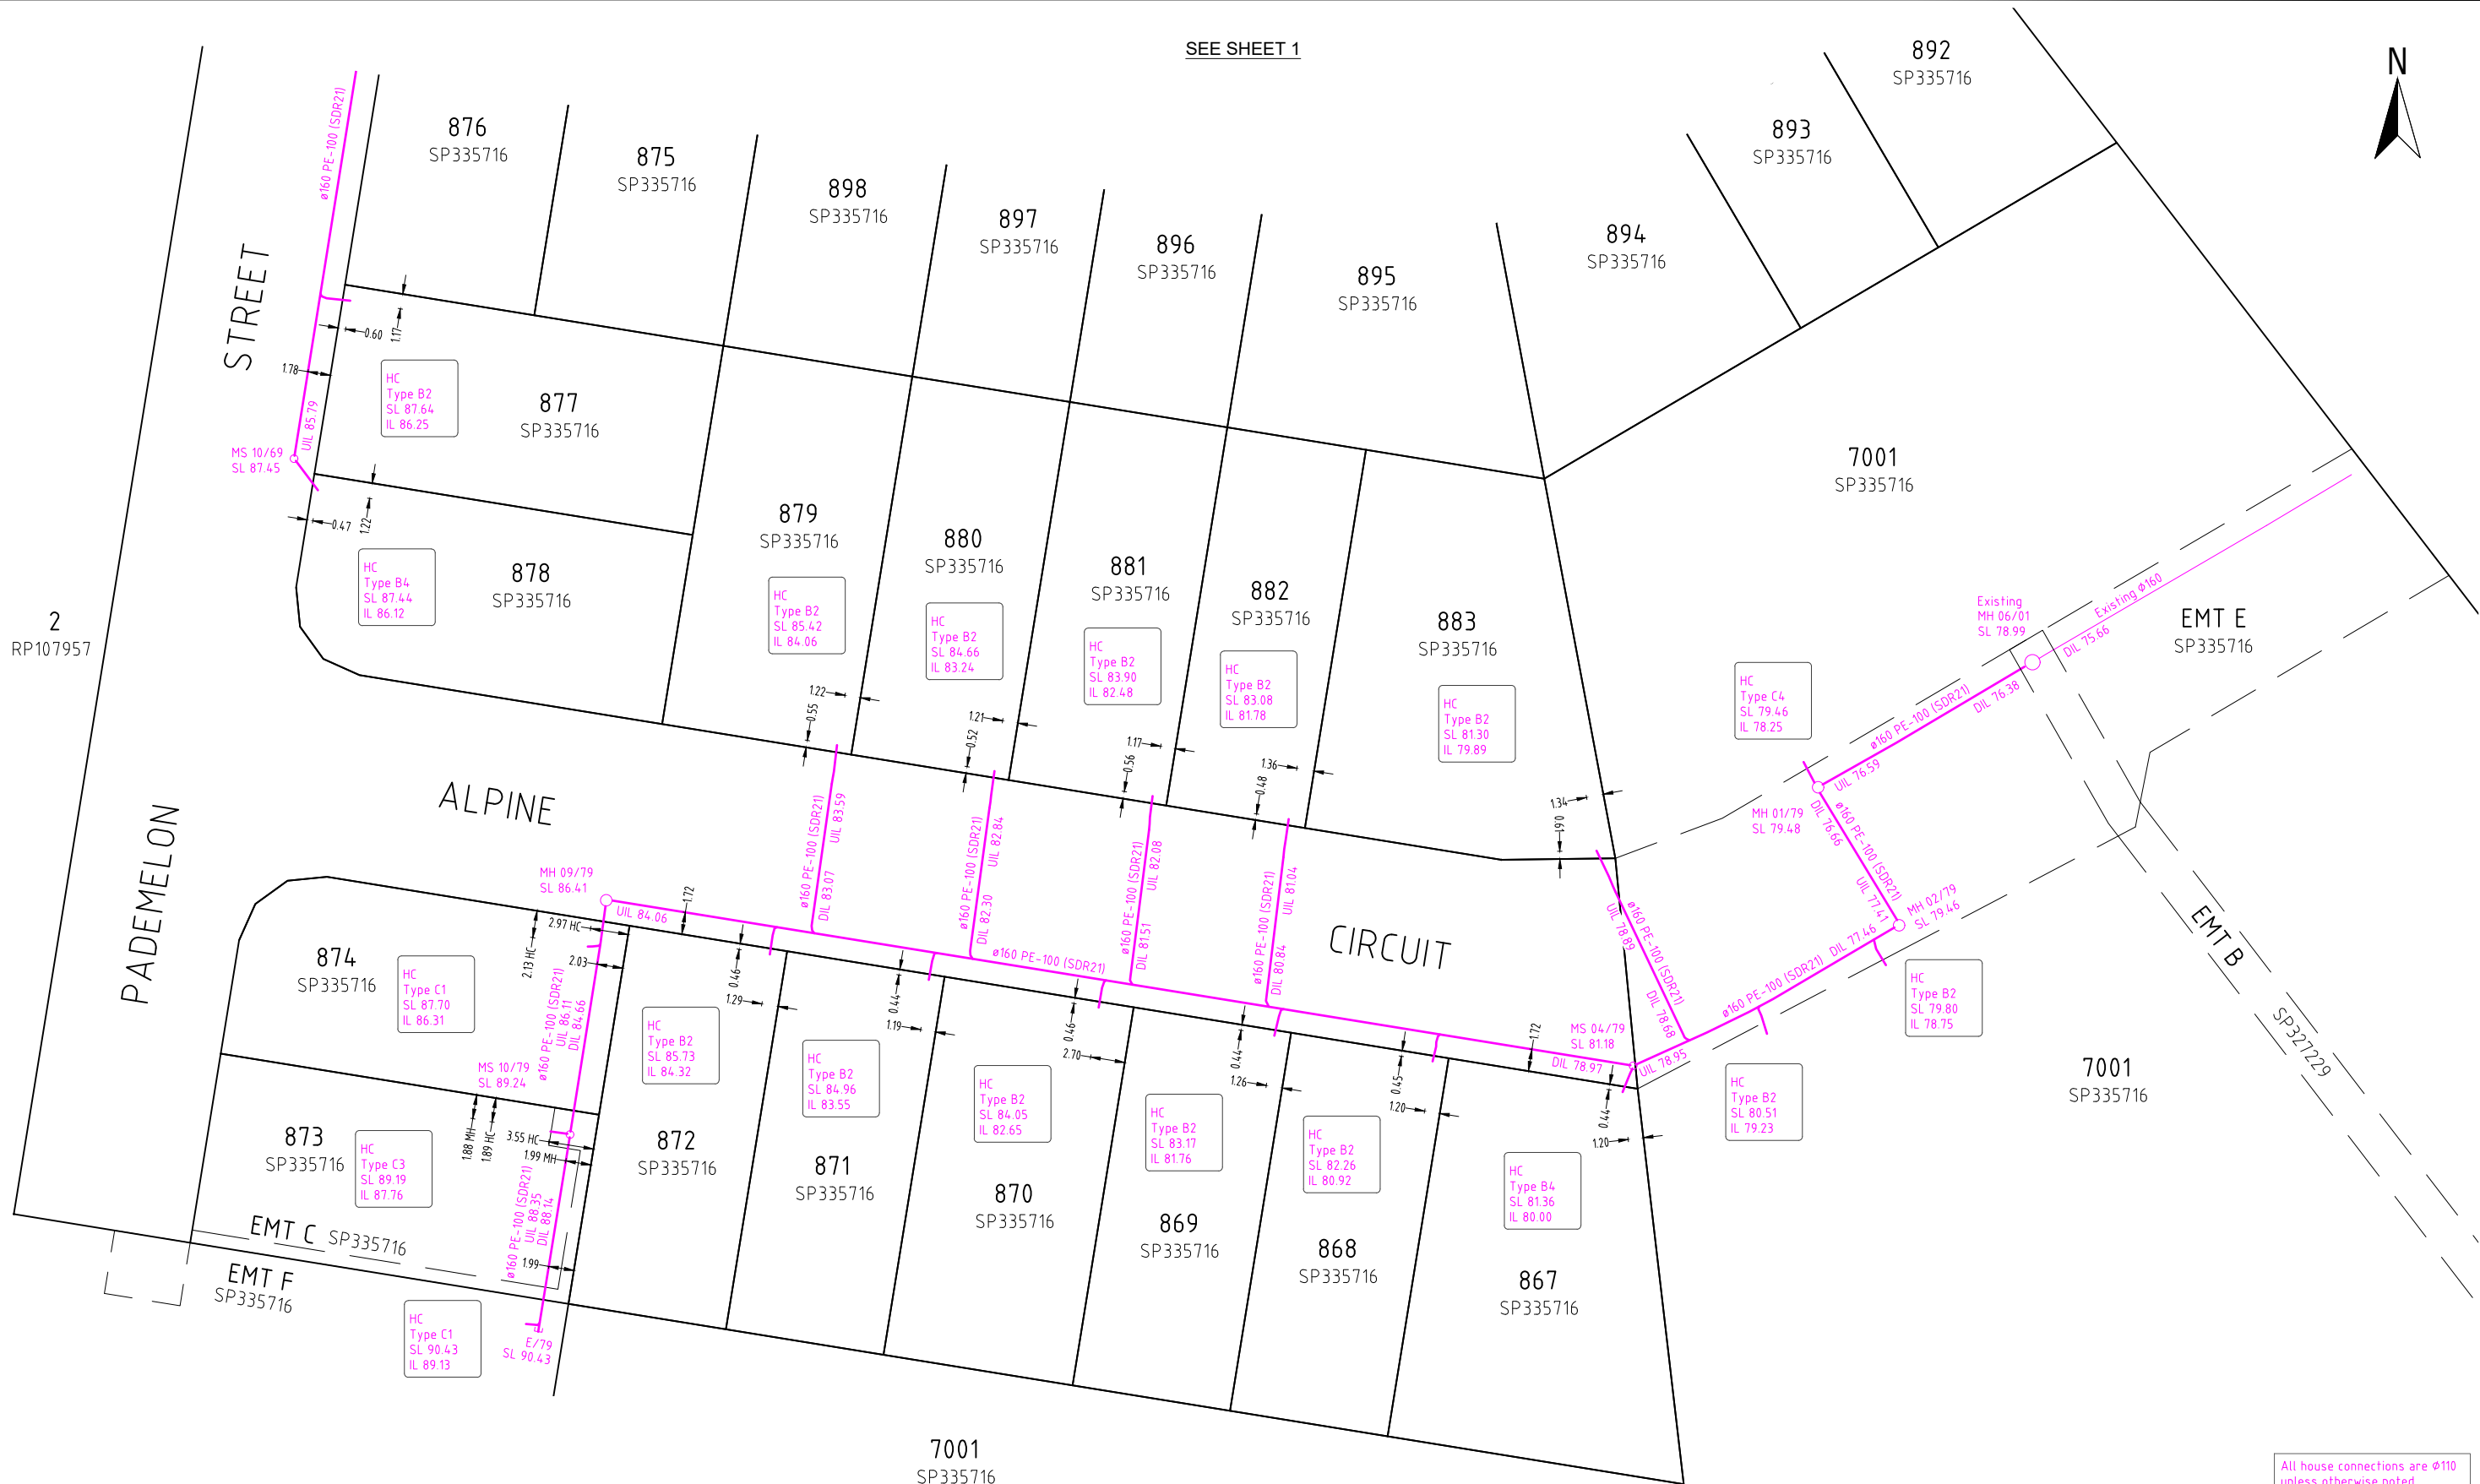

All house connections are 110 unless otherwise noted.



SCALE OF METRES
1 : 250 FULL SIZE A1 SHEET

A1

REV NO	DATE	REVISION PURPOSE / DESCRIPTION	DRAWN	RPEQ	RPEQ No
A	30.05.2024	Builders Issue			


DRAWN	CM	15.05.2024
CHECKED	CU	16.05.2024
APPROVED		

saunders havill group
 Saunders Havill Group Pty Ltd ABN 24 144 992 949
 head office 9 Thompson St Bowen Hills Q 4006
 phone: 0800 623 5HG web: www.saundershavill.com
 ■ surveying ■ town planning ■ urban design ■ environmental management ■ landscape architecture



EDEN'S CROSSING - STAGE 16
 SUNBIRD DRIVE, REDBANK PLAINS
 PLAN OF ADAC SURVEY DATA
 SEWERAGE RETICULATION 22-PNT-56638

DRAWING STATUS	
AS CONSTRUCTED	
SHEET 2 OF 2 SHEETS	
DRAWING NO.	REV.
	A

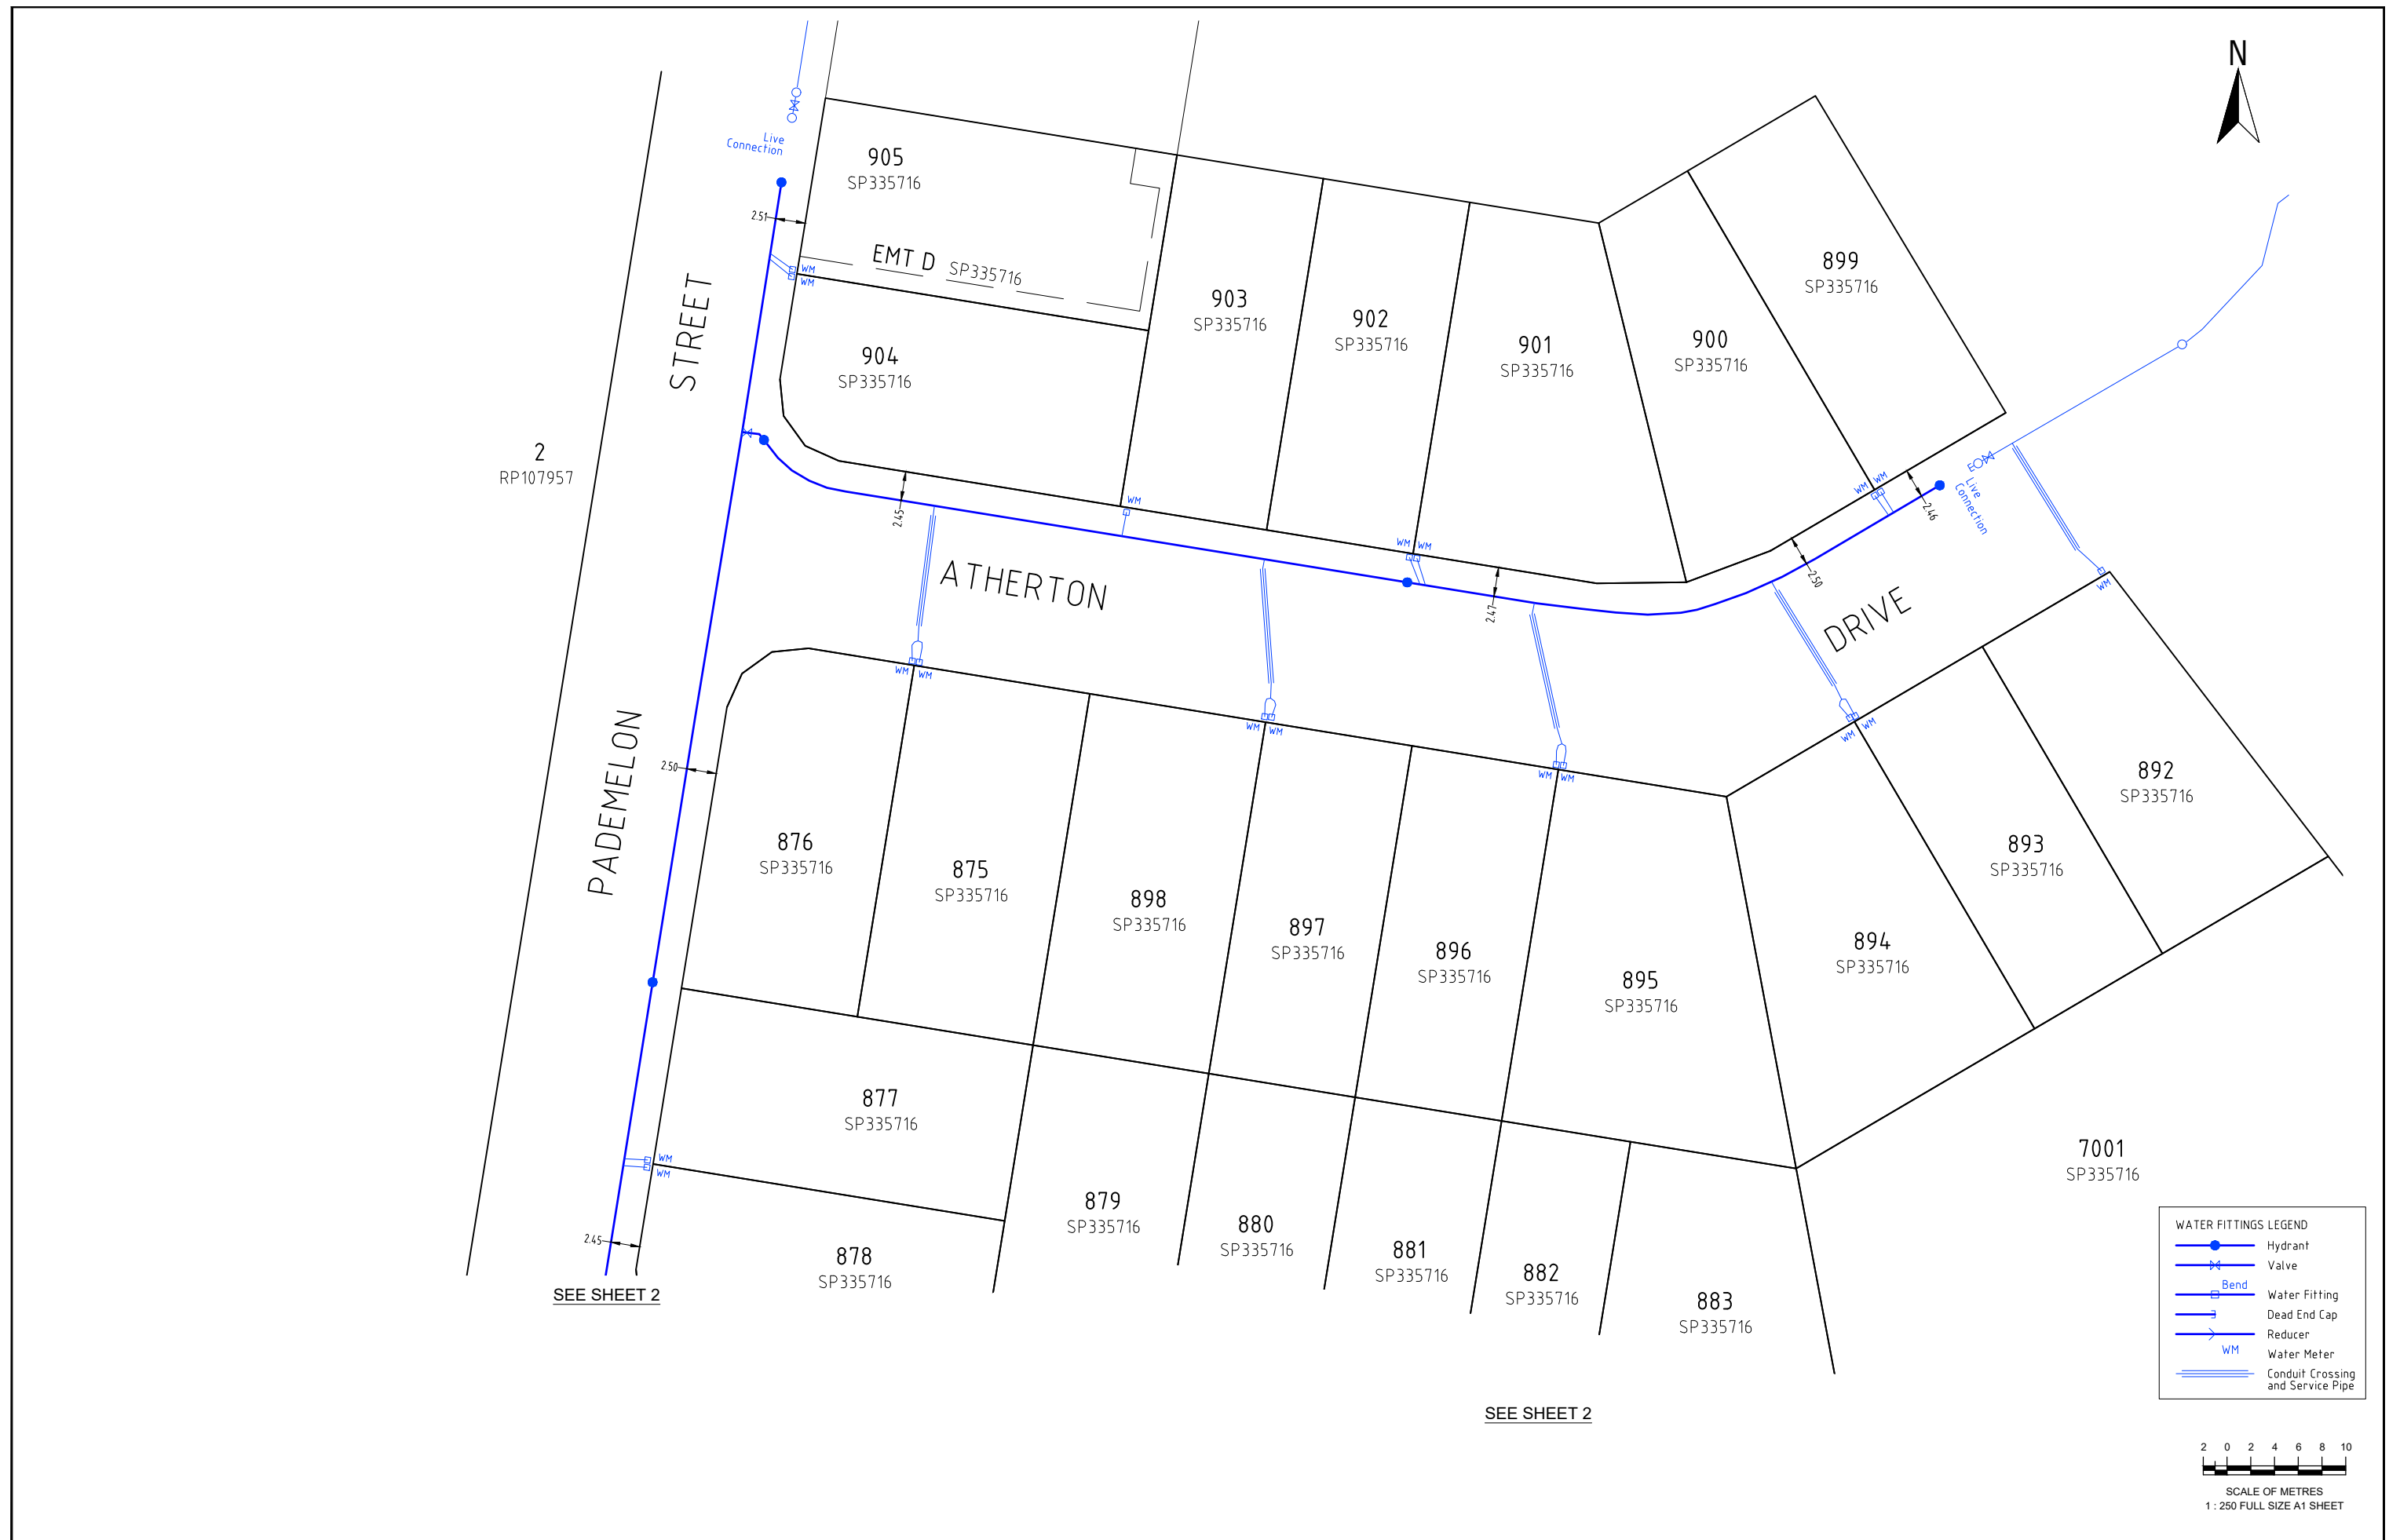

A1

REV NO	DATE	REVISION PURPOSE / DESCRIPTION	DRAWN	RPEQ	RPEQ No
A	30.05.2024	Builders Issue			


DRAWN	CM	15.05.2024
CHECKED	CU	16.05.2024
APPROVED		

SH saunders havill group
 Saunders Havill Group Pty Ltd ABN 24 444 592 949
 head office 9 Thompson St Bowen Hills Q 4006
 phone: 800 423 5HG web: www.saundershavill.com
 ■ surveying ■ town planning ■ urban design ■ environmental management ■ landscape architecture
 Drawing No: 9112 S 56 AC A



EDEN'S CROSSING - STAGE 16
 SUNBIRD DRIVE, REDBANK PLAINS
 PLAN OF ADAC SURVEY DATA
 WATER RETICULATION 22-PNT-56638

DRAWING STATUS	
AS CONSTRUCTED	
SHEET 1 OF 2 SHEETS	
DRAWING NO.	REV.
	A

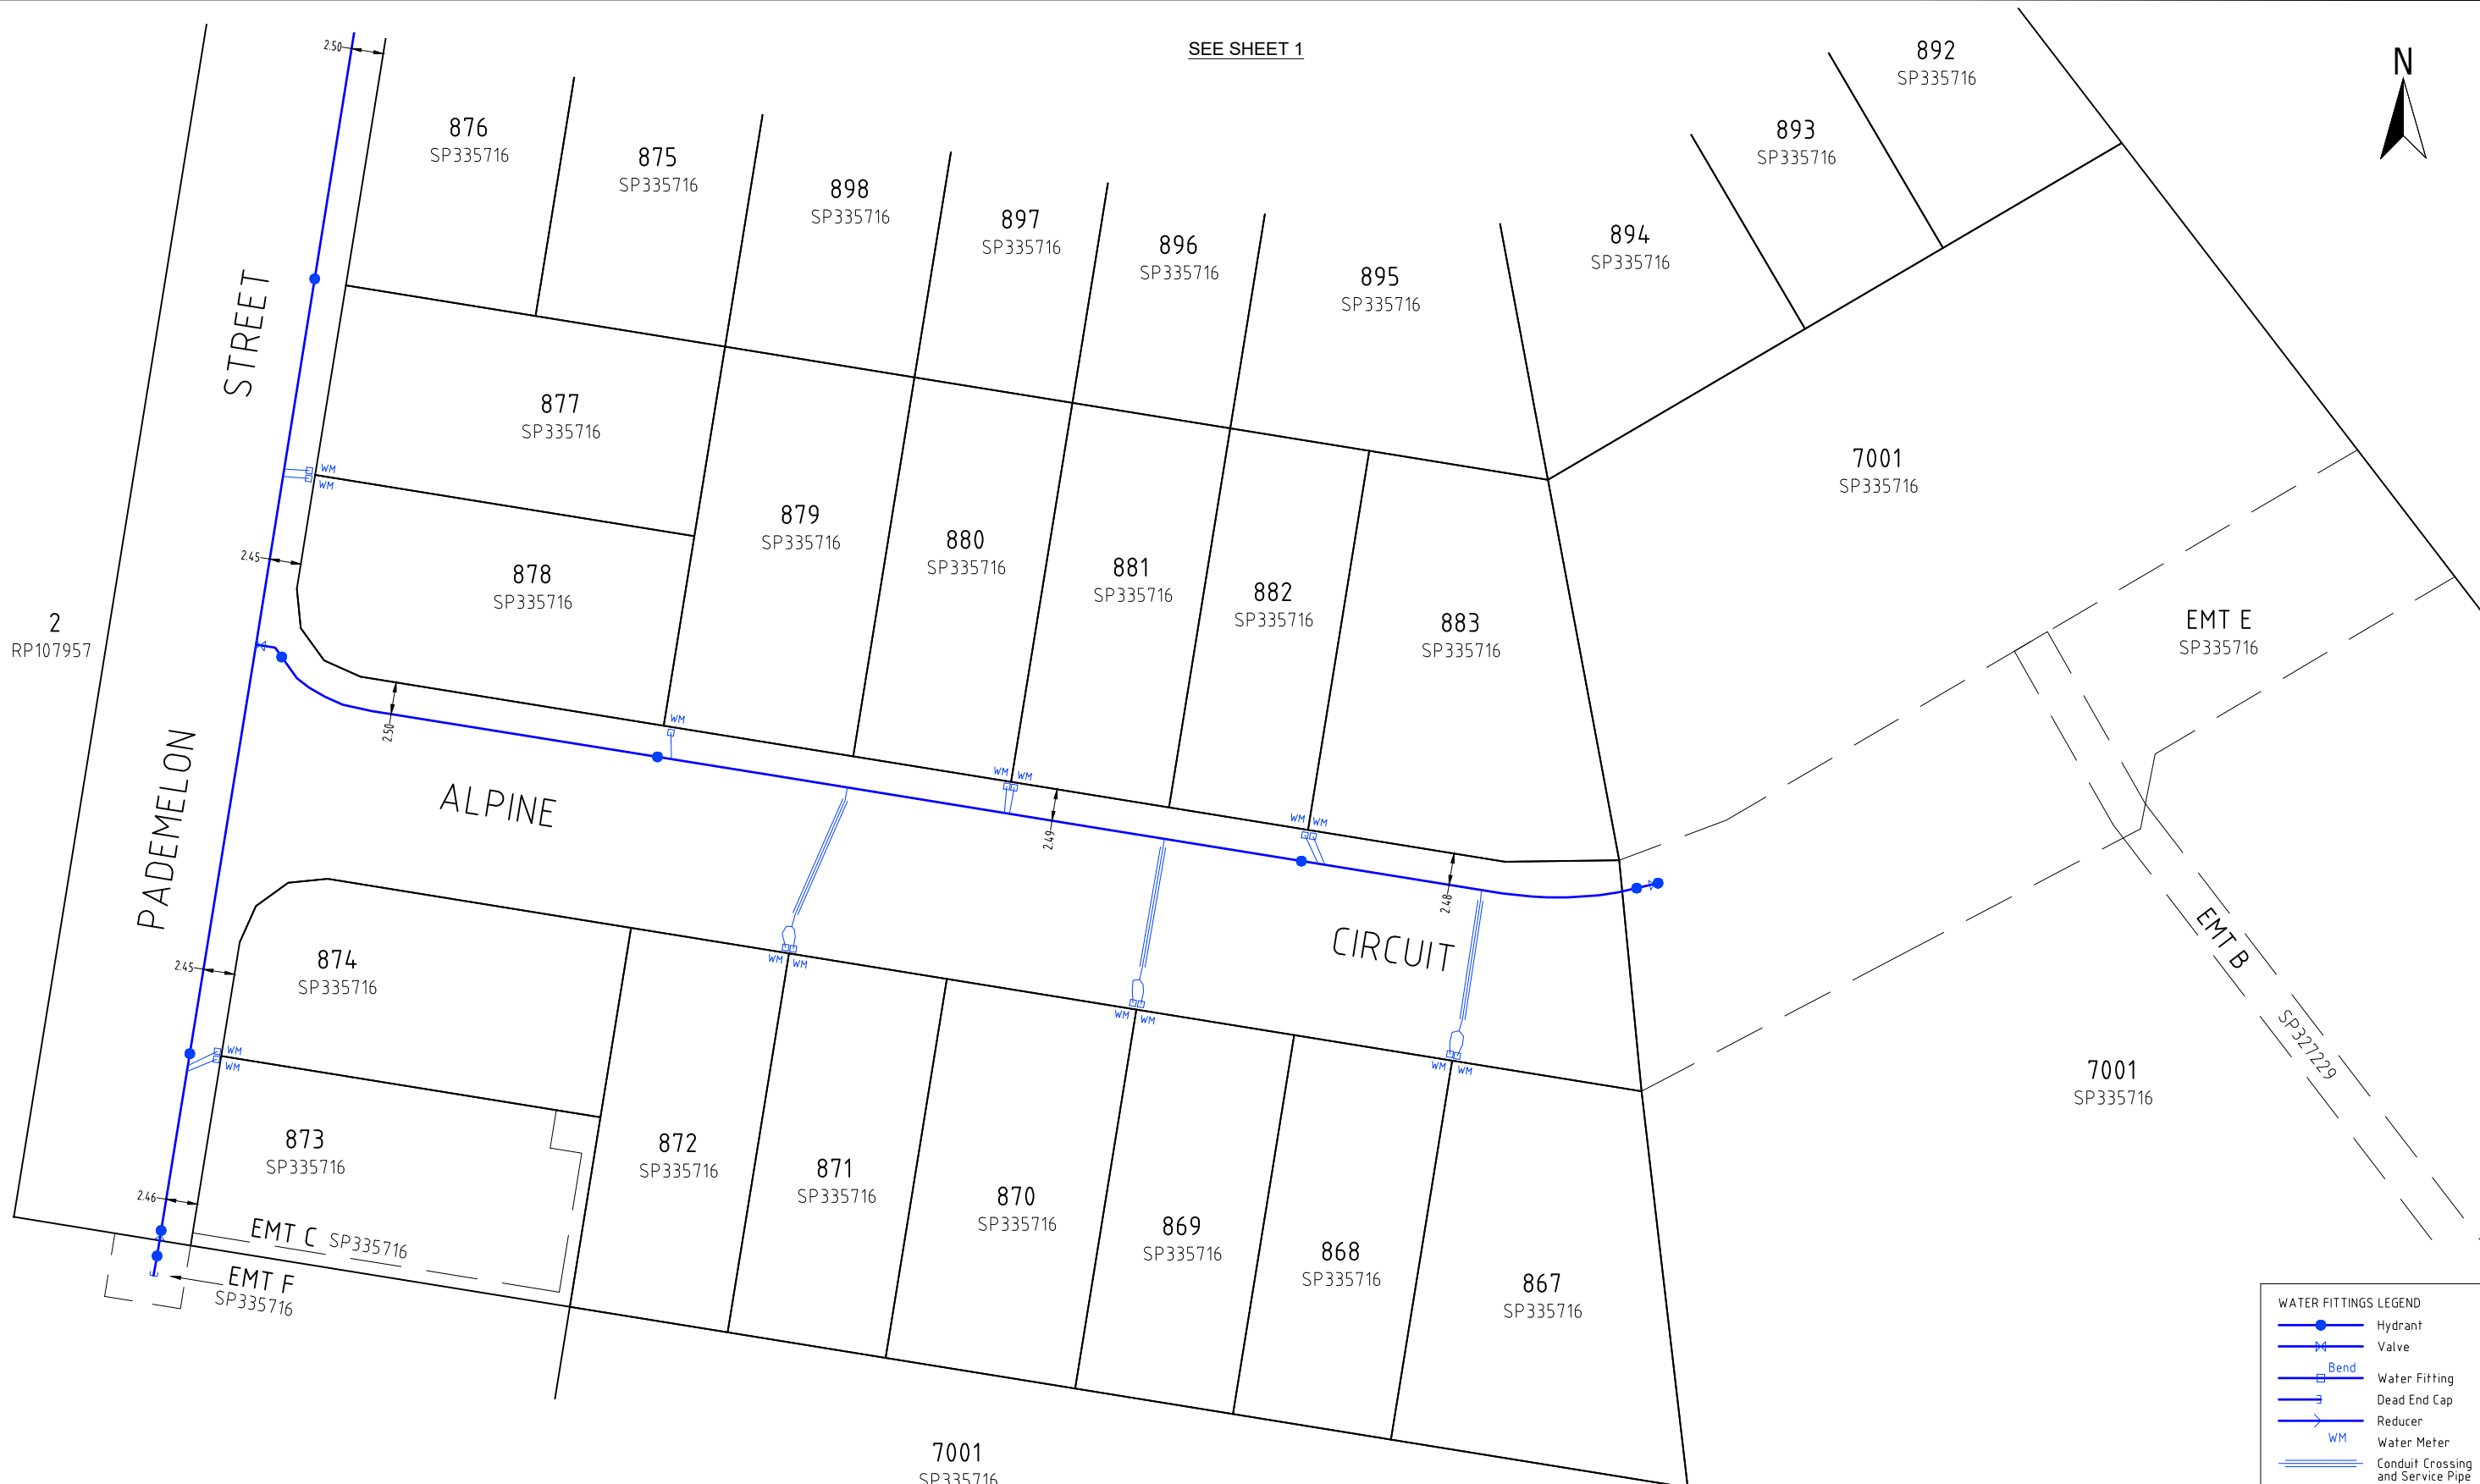

SEE SHEET 1



2
RP107957

EMT E
SP335716

EMT B
SP327229

PADMELON
STREET


ALPINE

CIRCUIT

7001
SP335716

WATER FITTINGS LEGEND

	Hydrant
	Valve
	Bend
	Water Fitting
	Dead End Cap
	Reducer
	Water Meter
	Conduit Crossing and Service Pipe

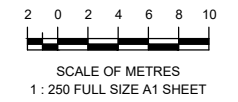

A1

REV NO	DATE	REVISION PURPOSE / DESCRIPTION	DRAWN	RPEQ	RPEQ No
A	30.05.2024	Builders Issue			

DRAWN	CM	15.05.2024
CHECKED	CU	16.05.2024
APPROVED		

SH saunders havill group
 Saunders Havill Group Pty Ltd ABN 24 444 992 949
 head office 5 Thompson St Bowen Hills Q 4006
 phone: 0800 423 5HG web: www.saundershavill.com
 ■ surveying ■ town planning ■ urban design ■ environmental management ■ landscape architecture
 Drawing No: 9112 S 56 AC A



EDEN'S CROSSING - STAGE 16
 SUNBIRD DRIVE, REDBANK PLAINS
 PLAN OF ADAC SURVEY DATA
 WATER RETICULATION 22-PNT-56638

DRAWING STATUS AS CONSTRUCTED	
SHEET 2 OF 2 SHEETS	
DRAWING NO.	REV. A