


**LEGEND:**

- STORMWATER PIPE
- EXISTING STORMWATER
- STORMWATER MANHOLE
- STORMWATER PIT
- ↓ KERB ADAPTER
- ROOFWATER PIPE
- KERB BACK
- CONCRETE PATH
- SEWER MAIN NON PRESSURE
- EXISTING SEWER
- SEWER HOUSE CONNECTION
- SEWER MAINTENANCE HOLE
- WATERMAIN
- EXISTING WATER MAIN
- HYDRANT
- ⊕ VALVE
- ⊕ WATER SERVICE METER
- WATER SERVICE PIPE
- WATER CONDUIT

**COORDINATE DATUM NOTE:**  
 HORIZONTAL COORDINATES(E,N) SUPPLIED ARE MAPPING GRID OF AUSTRALIA(MGA),  
 ZONE 56 BASED ON THE UNIVERSAL TRANSVERSE MERCATOR PROJECTION AND THE  
 GEOCENTRIC DATUM OF AUSTRALIA 1994.

**AS CONSTRUCTED**

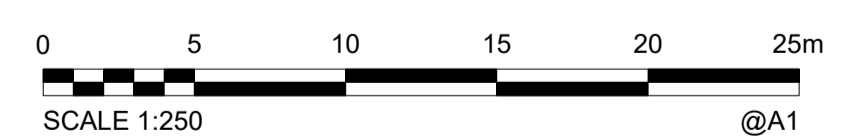

SB3594/21-100-SKETCH

DRAWING REVISIONS		REFERENCE DRAWINGS		DESIGN FILE No.		DESIGNED	
REV.	REVISION DESCRIPTION	DRG. No.	DESCRIPTION	CONSTRUCT. No.	DATE	DATE	JC
A	BUILDERS SKETCH PLAN						

**WOLTER**  
consulting group


Planning Urban Design Landscape Environment Surveying  
 Brisbane: Level 2, 1 Breakfast Ck Road, Newstead, QLD 4006 Phone: (07) 3666 5200

**CITY OF MORETON BAY**

MORETON BAY CITY  
 CABOOLTURE DISTRICT OFFICE  
 2 HASKING STREET CABOOLTURE QLD 4510  
 PO BOX 159 CABOOLTURE QLD 4510  
 Telephone: (07) 3205 0555  
 Email: council@moretonbay.qld.gov.au

**RIVERBANK**  
 STAGE 21  
 BUILDERS SKETCH PLAN

SUBDIVISION REFERENCE	
No. 1 OF 2 PLANS	REV.
ASCEN GRID NUMBER	A

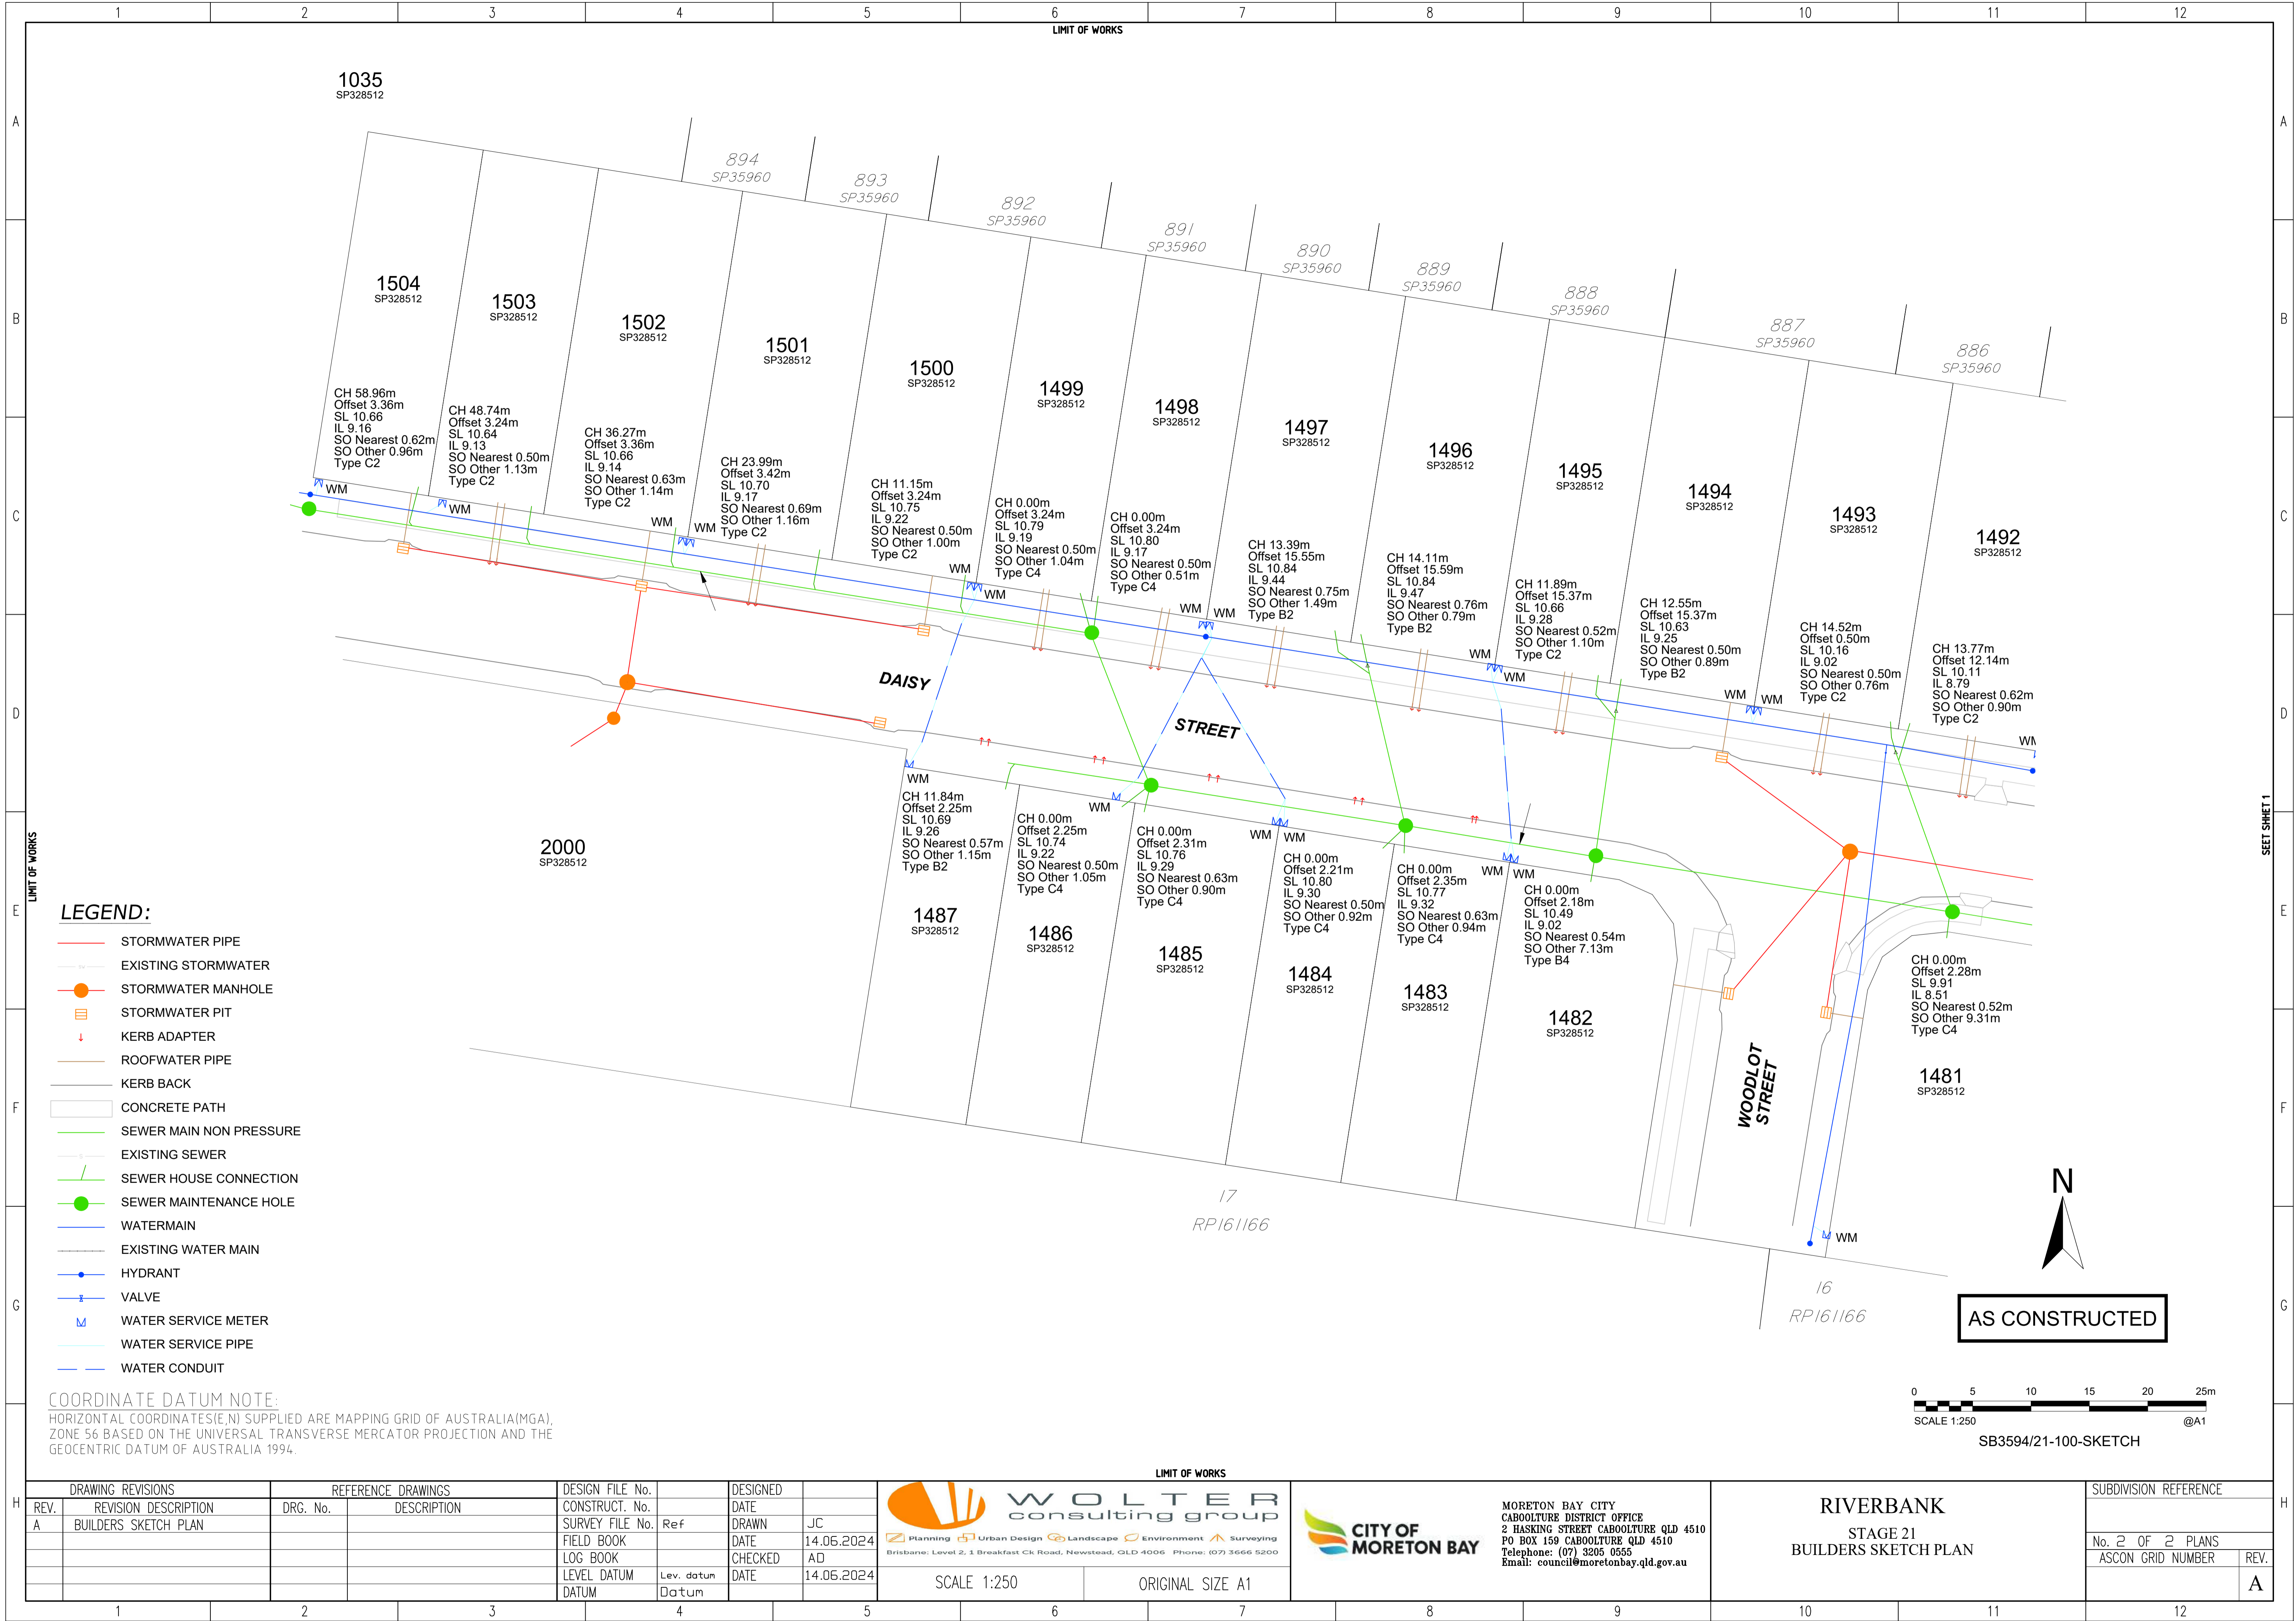


**LEGEND:**

- STORMWATER PIPE
- EXISTING STORMWATER
- STORMWATER MANHOLE
- STORMWATER PIT
- ↓ KERB ADAPTER
- ROOFWATER PIPE
- KERB BACK
- CONCRETE PATH
- SEWER MAIN NON PRESSURE
- EXISTING SEWER
- / SEWER HOUSE CONNECTION
- SEWER MAINTENANCE HOLE
- WATERMAIN
- EXISTING WATER MAIN
- HYDRANT
- + VALVE
- M WATER SERVICE METER
- WATER SERVICE PIPE
- WATER CONDUIT

**COORDINATE DATUM NOTE:**

HORIZONTAL COORDINATES(E,N) SUPPLIED ARE MAPPING GRID OF AUSTRALIA(MGA), ZONE 56 BASED ON THE UNIVERSAL TRANSVERSE MERCATOR PROJECTION AND THE GEOCENTRIC DATUM OF AUSTRALIA 1994.

**AS CONSTRUCTED**

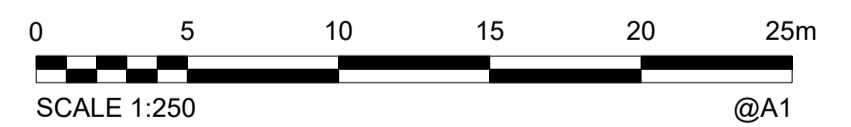

SB3594/21-100-SKETCH

DRAWING REVISIONS		REFERENCE DRAWINGS		DESIGN FILE No.		DESIGNED	
REV.	REVISION DESCRIPTION	DRG. No.	DESCRIPTION	CONSTRUCT. No.	DATE	DATE	JC
A	BUILDERS SKETCH PLAN						
				SURVEY FILE No.	Ref	DRAWN	JC
				FIELD BOOK		DATE	14.06.2024
				LOG BOOK		CHECKED	AD
				LEVEL DATUM	Lev. datum	DATE	14.06.2024
				DATUM			

**WOLTER**  
consulting group

Planning Urban Design Landscape Environment Surveying  
 Brisbane: Level 2, 1 Breakfast Ck Road, Newstead, QLD 4006 Phone: (07) 3666 5200

**CITY OF MORETON BAY**

MORETON BAY CITY  
 CABOOLTURE DISTRICT OFFICE  
 2 HASKING STREET CABOOLTURE QLD 4510  
 PO BOX 159 CABOOLTURE QLD 4510  
 Telephone: (07) 3205 0555  
 Email: council@moretonbay.qld.gov.au

**RIVERBANK**  
STAGE 21  
BUILDERS SKETCH PLAN

SUBDIVISION REFERENCE	
No. 2 OF 2 PLANS	
ASCION GRID NUMBER	REV.
	A