


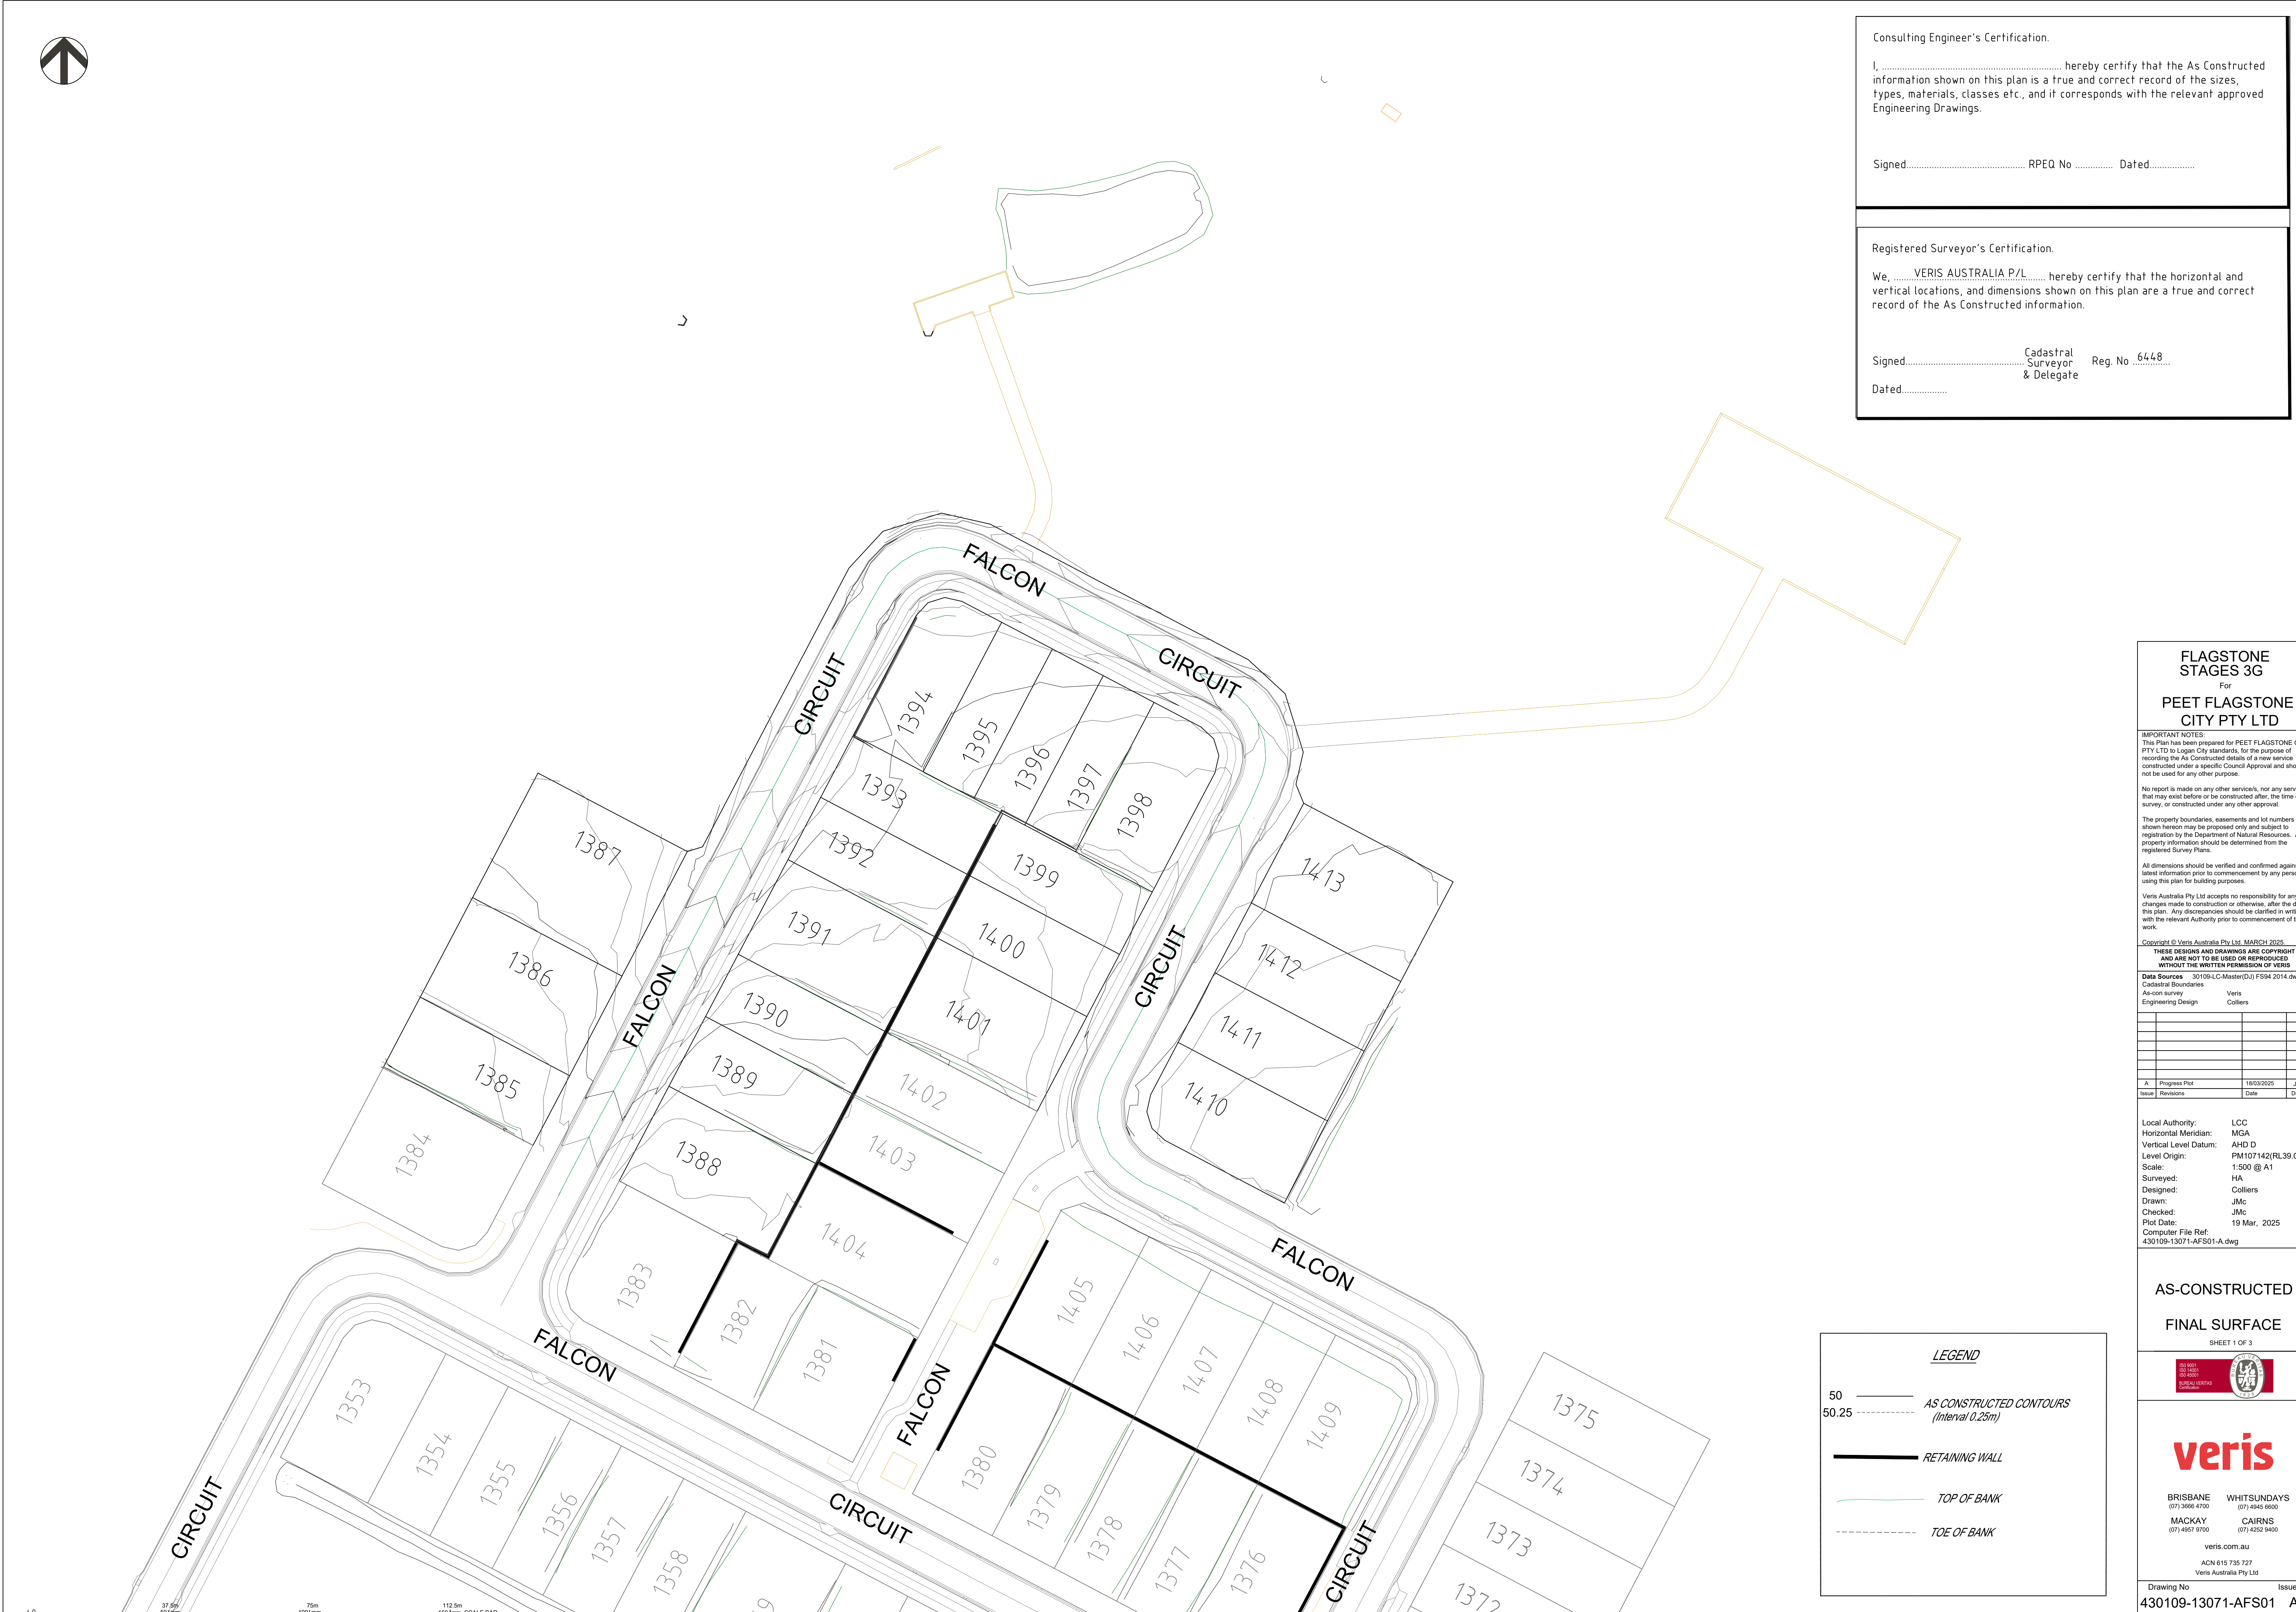

Signed..... RPEQ No Dated.....

Signed..... Cadastral Surveyor Reg. No 6448
& Delegate
Dated.....

Accounting No	Issue
100 13071 AFS01	A

Consulting Engineer's Certification.

I, hereby certify that the As Constructed information shown on this plan is a true and correct record of the sizes, types, materials, classes etc., and it corresponds with the relevant approved Engineering Drawings.

Signed..... RPEQ No Dated.....

Registered Surveyor's Certification.

We, VERIS AUSTRALIA P/L hereby certify that the horizontal and vertical locations, and dimensions shown on this plan are a true and correct record of the As Constructed information.

Signed..... Cadastral Surveyor & Delegate Reg. No 6448
Dated.....



FLAGSTONE
STAGE 3G
For
PEET FLAGSTONE
CITY PTY LTD

IMPORTANT NOTES:
This Plan has been prepared for PEET FLAGSTONE CITY PTY LTD to Logan City standards, for the purpose of recording the As Constructed details of a new service constructed under a specific Council Approval and should not be used for any other purpose.

No report is made on any other services, nor any services that may exist before or be constructed after, the time of survey, or constructed under any other approval.

The property boundaries, easements and lot numbers shown hereon may be proposed only and subject to registration by the Department of Natural Resources. All property information should be determined from the registered Survey Plans.

All dimensions should be verified and confirmed against the latest information prior to commencement by any person using this plan for building purposes.

Veris Australia Pty Ltd accepts no responsibility for any changes made to construction or otherwise, after the date of this plan. Any discrepancies should be clarified in writing with the relevant Authority prior to commencement of the work.

Copyright © Veris Australia Pty Ltd. MARCH 2025.
THESE DESIGNS AND DRAWINGS ARE COPYRIGHT AND ARE NOT TO BE USED OR REPRODUCED WITHOUT THE WRITTEN PERMISSION OF VERIS.

Data Sources 30109-LC-Master(DJ) FS94 2014.dwg
Cadastral Boundaries Veris
As-con survey Colliers
Engineering Design

A	Progress Plot	18/03/2025	JMc
Issue	Revisions	Date	Drawn

Local Authority: LCC
Horizontal Meridian: MGA
Vertical Level Datum: AHD D
Level Origin: PM107142(RL39.078)
Scale: 1:250 @ A1
Surveyed: HA
Designed: Colliers
Drawn: JMc
Checked: JMc
Plot Date: 19 Mar, 2025
Computer File Ref: 430109-13071-AFS01-A.dwg

AS-CONSTRUCTED
FINAL SURFACE

SHEET 2 OF 3



veris

BRISBANE WHITSUNDAYS
(07) 3666 4700 (07) 4945 6600
MACKAY CAIRNS
(07) 4957 9700 (07) 4252 9400

veris.com.au
ACN 815 735 727
Veris Australia Pty Ltd

Drawing No 430109-13071-AFS01 A Issue

LEGEND


50 — AS CONSTRUCTED CONTOURS
50.25 (Interval 0.25m)

— RETAINING WALL

— TOP OF BANK

- - - - - TOE OF BANK

12.5m 50mm 25m 100mm 37.5m 150mm SCALE BAR

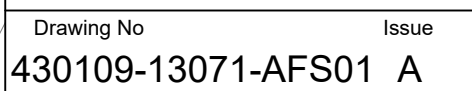

TOE OF BANK

/

/



SHEET 3

FLAGSTONE
STAGES 3F & 3H
For
PEET FLAGSTON
CITY PTY LTD

S-CONSTRUCTED
FINAL SURFACE
SHEET 1 OF 3



veris

BANE WHITSUNDAYS
0866 4700 (07) 4945 6600

CKAY CAIRNS
057 9700 (07) 4252 9400

veris.com.au
ACN 615 735 727
Veris Australia Pty Ltd

Drawing No	Issue
109-13061-AES01	B

Consulting Engineer's Certification.

I, hereby certify that the As Constructed information shown on this plan is a true and correct record of the sizes, types, materials, classes etc., and it corresponds with the relevant approved Engineering Drawings.

Signed..... RPEQ No Dated.....

Registered Surveyor's Certification.

We, VERIS AUSTRALIA P/L hereby certify that the horizontal and vertical locations, and dimensions shown on this plan are a true and correct record of the As Constructed information.

Signed..... Cadastral Surveyor & Delegate Reg. No. 6448...

Dated.....

LEGEND

50 ——— AS CONSTRUCTED CONTOURS
50.25 - - - - - (Interval 0.25m)

————— RETAINING WALL

————— TOP OF BANK

- - - - - TOE OF BANK

FLAGSTONE
STAGE 3F & 3H
For
PEET FLAGSTONE
CITY PTY LTD

IMPORTANT NOTES:
This Plan has been prepared for PEET FLAGSTONE CITY PTY LTD to Logan City standards, for the purpose of recording the As Constructed details of a new service constructed under a specific Council Approval and should not be used for any other purpose.
No report is made on any other services, nor any services that may exist before or be constructed after, the time of survey, or constructed under any other approval.
The property boundaries, easements and lot numbers shown hereon may be proposed only and subject to registration by the Department of Natural Resources. All property information should be determined from the registered Survey Plans.
All dimensions should be verified and confirmed against the latest information prior to commencement by any person using this plan for building purposes.
Veris Australia Pty Ltd accepts no responsibility for any changes made to construction or otherwise, after the date of this plan. Any discrepancies should be clarified in writing with the relevant Authority prior to commencement of the work.


Veris Australia Pty Ltd November 2024.
THESE DESIGNS AND DRAWINGS ARE COPYRIGHT AND ARE NOT TO BE USED OR REPRODUCED WITHOUT THE WRITTEN PERMISSION OF VERIS.
Data Sources : 30109-LC-Master(DJ) FS94 2014.dwg
As-con survey Veris
Engineering Design Colliers

B	Progress Plot	18.03.2025	JMc
A	Progress Plot	21.11.2024	JMc
Issue	Revisions	Date	Drawn

B	Progress Plot	18.03.2025	JMc
A	Progress Plot	21.11.2024	JMc
Issue	Revisions	Date	Drawn

Local Authority: LCC
Horizontal Meridian: MGA
Vertical Level Datum: AHD D
Level Origin: PM107142(RL39.078)
Scale: 1:250 @ A1
Surveyed: HA
Designed: Colliers
Drawn: JMc
Checked: JMc
Plot Date: 19 Mar, 2025
Computer File Ref: 430109-13061-AFS01-B.dwg

AS-CONSTRUCTED
FINAL SURFACE

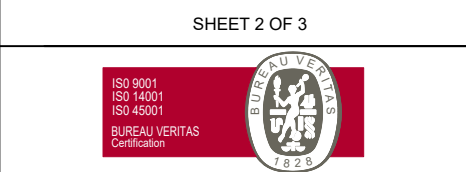

veris

BRISBANE (07) 3666 4700 WHITSUNDAYS (07) 4945 6600
MACKAY (07) 4957 9700 CAIRNS (07) 4252 9400

veris.com.au
ACN 615 735 727
Veris Australia Pty Ltd

Drawing No 430109-13061-AFS01 B Issue



LEGEND

50 ——— AS CONSTRUCTED CONTOURS
50.25 - - - - - (Interval 0.25m)

————— RETAINING WALL

————— TOP OF BANK

- - - - - TOE OF BANK

Consulting Engineer's Certification.

I, hereby certify that the As Constructed information shown on this plan is a true and correct record of the sizes, types, materials, classes etc., and it corresponds with the relevant approved Engineering Drawings.

Signed..... RPEQ No Dated.....

Registered Surveyor's Certification.

We, VERIS AUSTRALIA P/L hereby certify that the horizontal and vertical locations, and dimensions shown on this plan are a true and correct record of the As Constructed information.

Signed..... Cadastral Surveyor & Delegate Reg. No. 6448

Dated.....

FLAGSTONE STAGE 3F+3H
For
PEET FLAGSTONE CITY PTY LTD

IMPORTANT NOTES:
This Plan has been prepared for PEET FLAGSTONE CITY PTY LTD to Logan City standards, for the purpose of recording the As Constructed details of a new service constructed under a specific Council Approval and should not be used for any other purpose.
No report is made on any other services, nor any services that may exist before or be constructed after, the time of survey, or constructed under any other approval.
The property boundaries, easements and lot numbers shown hereon may be proposed only and subject to registration by the Department of Natural Resources. All property information should be determined from the registered Survey Plans.
All dimensions should be verified and confirmed against the latest information prior to commencement by any person using this plan for building purposes.
Veris Australia Pty Ltd accepts no responsibility for any changes made to construction or otherwise, after the date of this plan. Any discrepancies should be clarified in writing with the relevant Authority prior to commencement of the work.
Copyright © Veris Australia Pty Ltd. November 2024.
THESE DESIGNS AND DRAWINGS ARE COPYRIGHT AND ARE NOT TO BE USED OR REPRODUCED WITHOUT THE WRITTEN PERMISSION OF VERIS
Data Sources 30109-LC-Master(DJ) FS94 2014.dwg
As-con survey Veris
Engineering Design Colliers

Issue	Revisions	Date	Drawn
B	Progress Plot	18.03.2025	JMc
A	Progress Plot	21.11.2024	JMc

Local Authority: LCC
Horizontal Meridian: MGA
Vertical Level Datum: AHD D
Level Origin: PM107142(RL39.078)
Scale: 1:250 @ A1
Surveyed: HA
Designed: Colliers
Drawn: JMc
Checked: JMc
Plot Date: 19 Mar, 2025
Computer File Ref: 430109-13061-AFS01-B.dwg

AS-CONSTRUCTED
FINAL SURFACE

SHEET 3 OF 3

veris

BRISBANE (07) 3666 4700 WHITSUNDAYS (07) 4945 6600
MACKAY (07) 4957 9700 CAIRNS (07) 4252 9400

veris.com.au
ACN 815 735 727
Veris Australia Pty Ltd

Drawing No Issue
430109-13061-AFS01 B



SHEET 2

SHEET 3

Stage3D
Basin

90302

Consulting Engineer's Certification.

I, hereby certify that the As Constructed information shown on this plan is a true and correct record of the sizes, types, materials, classes etc., and it corresponds with the relevant approved Engineering Drawings.

Signed..... RPEQ No Dated.....

Registered Surveyor's Certification.

We, VERIS AUSTRALIA P/L hereby certify that the horizontal and vertical locations, and dimensions shown on this plan are a true and correct record of the As Constructed information.

Signed..... Cadastral
Surveyor
& Delegate Reg. No ..6448..
Dated.....

FLAGSTONE
STAGE 3G
For
PEET FLAGSTONE
CITY PTY LTD

IMPORTANT NOTES:
This Plan has been prepared for PEET FLAGSTONE CITY PTY LTD to Logon City standards, for the purpose of recording the As Constructed details of a new service constructed under a specific Council Approval and should not be used for any other purpose.

No report is made on any other service's, nor any service's that may exist before or be constructed after, the time of survey, or constructed under any other approval.

The property boundaries, easements and lot numbers shown hereon may be proposed only and subject to registration by the Department of Natural Resources. All property information should be determined from the registered Survey Plans.

All dimensions should be verified and confirmed against the latest information prior to commencement by any person using this plan for building purposes.

Veris Australia Pty Ltd accepts no responsibility for any changes made to construction or otherwise, after the date of this plan. Any discrepancies should be clarified in writing with the relevant Authority prior to commencement of the work.

Copyright © Veris Australia Pty Ltd. MARCH 2005.

THESE DESIGNS AND DRAWINGS ARE COPYRIGHT AND ARE NOT TO BE USED OR REPRODUCED WITHOUT THE WRITTEN PERMISSION OF VERIS

Data Sources 30109-LC-Master(DP) F594 2014.dwg

Cadastral Boundaries As-con survey Veris
Engineering Design COLLIER'S

B	Progress Plot	17.03.2025	JMc
A	Progress Plot	05.03.2025	JMc
Issue	Revisions	Date	Drawn

Local Authority: LCC
Horizontal Meridian: MGA
Vertical Level Datum: AHD D
Level Origin: PM107142(RL39.078)
Scale: 1:750 @ A1
Surveyed: HA
Designed: COLLIER'S
Drawn: JMc
Checked: JMc
Plot Date: 17 Mar, 2025
Computer File Ref: 430109-13071-ASW01-B LOCAL.dwg

AS-CONSTRUCTED

STORMWATER

SHEET 1 OF 3



veris

BRISBANE (07) 3666 4700 WHITSUNDAYS (07) 4945 6600
MACKAY (07) 4957 9100 CAIRNS (07) 4232 9400

veris.com.au

ACN 615 735 727
Veris Australia Pty Ltd

Drawing No Issue
430109-13071-ASW01 B



Consulting Engineer's Certification.

I, hereby certify that the As Constructed information shown on this plan is a true and correct record of the sizes, types, materials, classes etc., and it corresponds with the relevant approved Engineering Drawings.

Signed..... RPEQ No Dated.....


Registered Surveyor's Certification.

We, VERIS AUSTRALIA P/L hereby certify that the horizontal and vertical locations, and dimensions shown on this plan are a true and correct record of the As Constructed information.

Signed..... Cadastral Surveyor & Delegate Reg. No. 6448.....

Dated.....

12.5m 50mm 25m 100mm 37.5m 150mm SCALE BAR

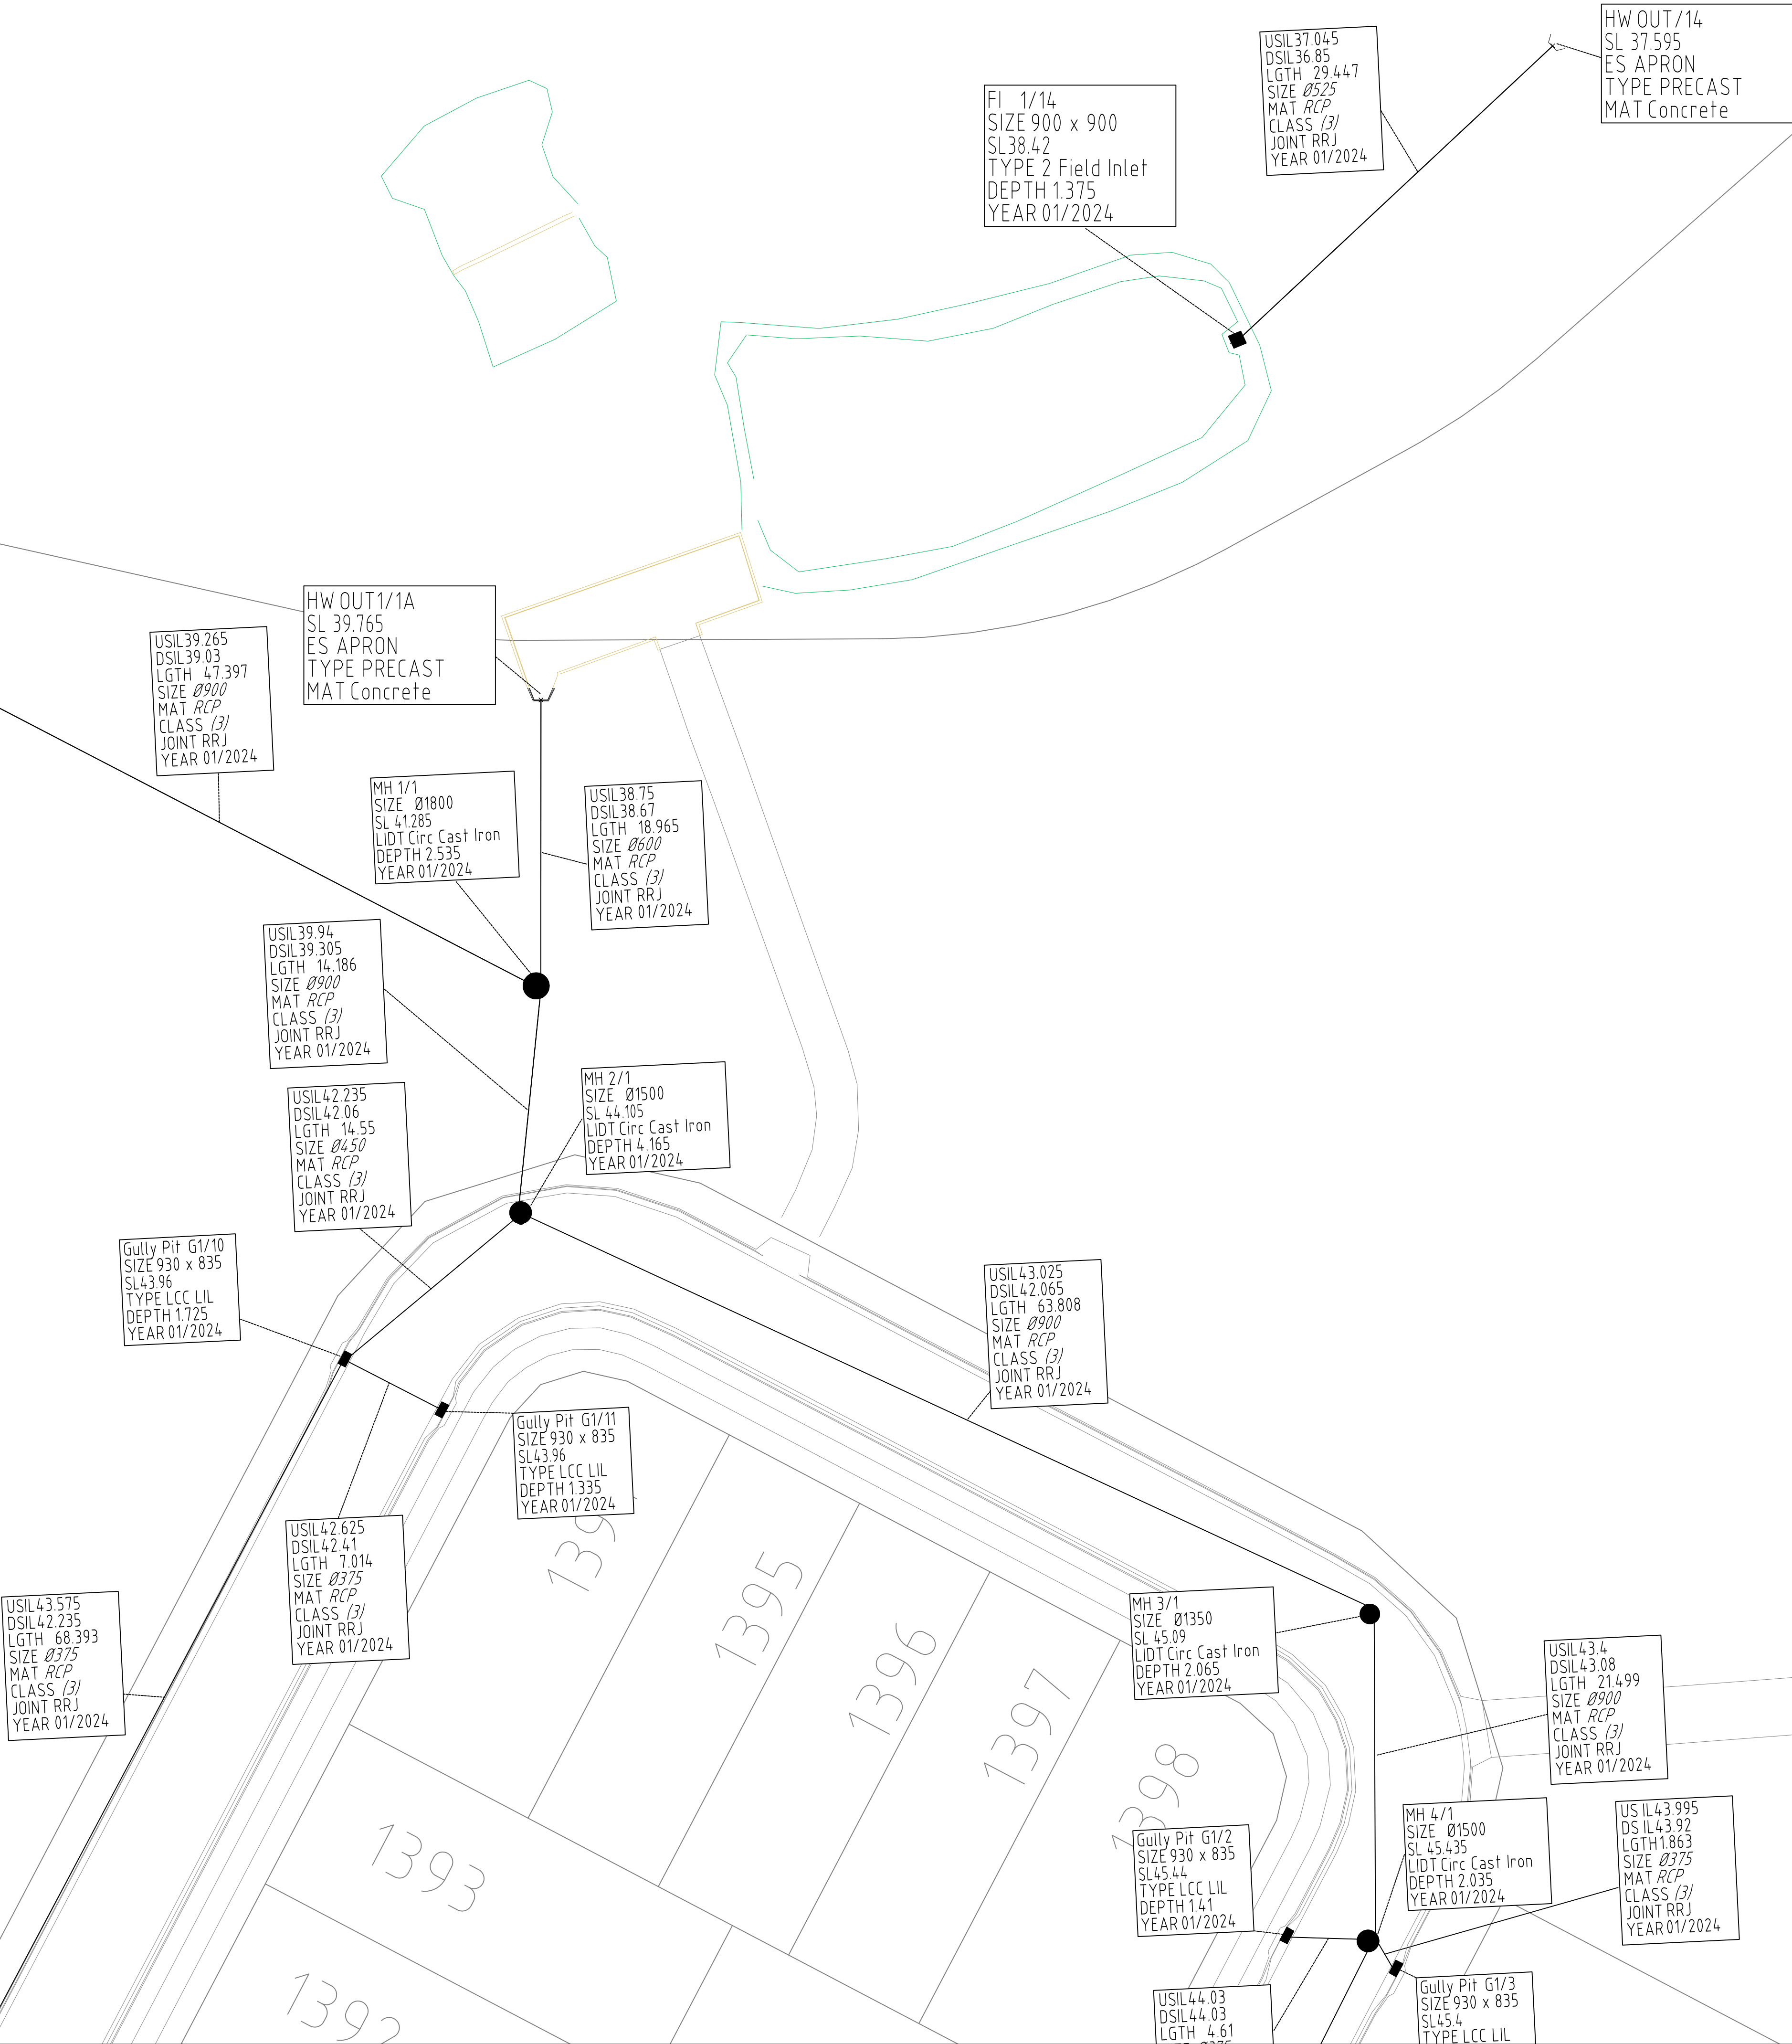

FLAGSTONE
STAGE 3G

For
PEET FLAGSTONE
CITY PTY LTD

IMPORTANT NOTES:

This Plan has been prepared for PEET FLAGSTONE CITY PTY LTD to Logon City standards, for the purpose of recording the As Constructed details of a new service constructed under a specific Council Approval and should not be used for any other purpose.

No report is made on any other service/s, nor any service/s that may exist before or be constructed after, the time of survey, or constructed under any other approval.

The property boundaries, easements and lot numbers shown hereon may be proposed only and subject to registration by the Department of Natural Resources. All property information should be determined from the registered Survey Plans.

All dimensions should be verified and confirmed against the latest information prior to commencement by any person using this plan for building purposes.

Veris Australia Pty Ltd accepts no responsibility for any changes made to construction or otherwise, after the date of this plan. Any discrepancies should be clarified in writing with the relevant Authority prior to commencement of the work.

Copyright © Veris Australia Pty Ltd. March 2025.

THESE DESIGNS AND DRAWINGS ARE COPYRIGHT AND ARE NOT TO BE USED OR REPRODUCED WITHOUT THE WRITTEN PERMISSION OF VERIS

Data Sources 30 109-LC-Master(DP) F894 2014.dwg

Cadastral Boundaries As-con survey Veris

Engineering Design COLLIERIES

B	Progress Plot	17.03.2025	JMc
A	Progress Plot	05.03.2025	JMc
Issue	Revisions	Date	Drawn

Local Authority: LCC

Horizontal Meridian: MGA

Vertical Level Datum: AHD D

Level Origin: PM107142(RL39.078)

Scale: 1:250 @ A1

Surveyed: HA

Designed: COLLIERIES

Drawn: JMc

Checked: JMc

Plot Date: 17 Mar, 2025

Computer File Ref: 430109-13071-ASW01-B LOCAL.dwg

AS-CONSTRUCTED

STORMWATER

SHEET 2 OF 3

BRISBANE
(07) 3666 4700

WHITSUNDAYS
(07) 4945 6600

MACKAY
(07) 4951 9100

CAIRNS
(07) 4222 9400

veris

BRISBANE
(07) 3666 4700

WHITSUNDAYS
(07) 4945 6600

MACKAY
(07) 4951 9100


CAIRNS
(07) 4222 9400

veris.com.au

ACN 615 735 727
Veris Australia Pty Ltd

Drawing No 430109-13071-ASW01 B

Issue

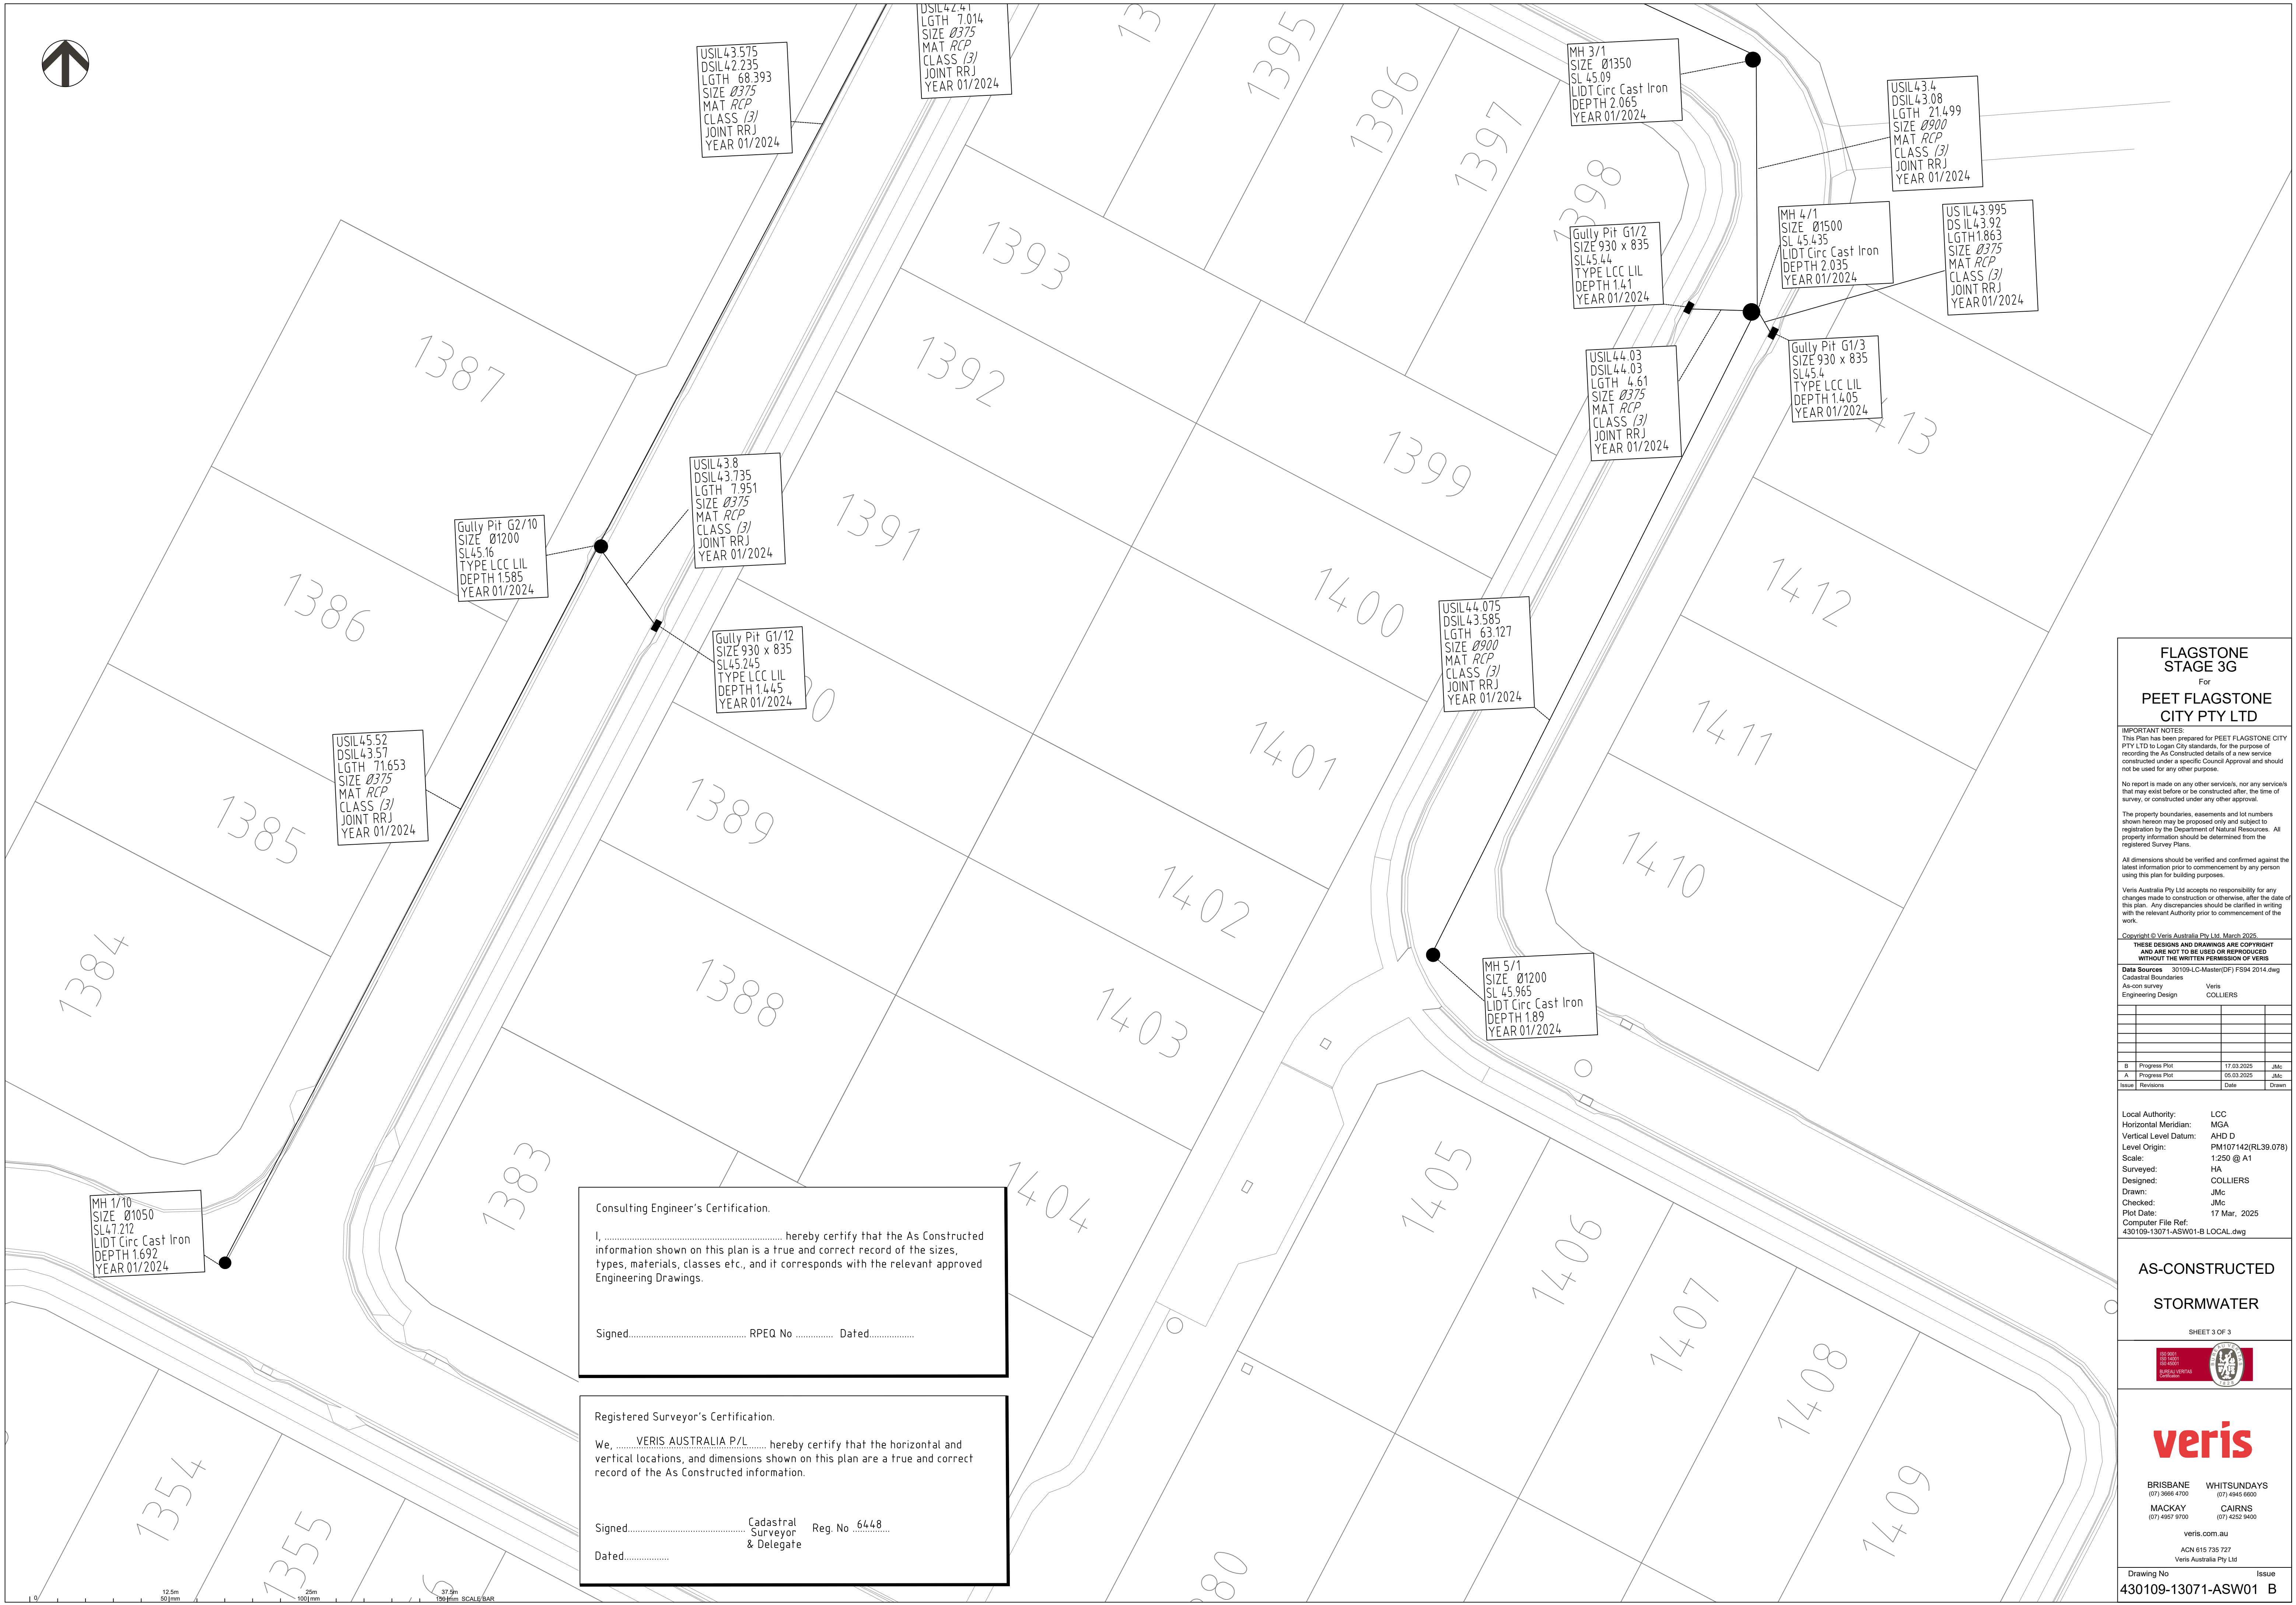

Consulting Engineer's Certification.

I, hereby certify that the As Constructed information shown on this plan is a true and correct record of the sizes, types, materials, classes etc., and it corresponds with the relevant approved Engineering Drawings.

Signed..... RPEQ No Dated.....

Registered Surveyor's Certification.

We, VERIS AUSTRALIA P/L hereby certify that the horizontal and vertical locations, and dimensions shown on this plan are a true and correct record of the As Constructed information.

Signed..... Cadastral Surveyor & Delegate Reg. No 6448

Dated.....

FLAGSTONE
STAGE 3G
For
PEET FLAGSTONE
CITY PTY LTD

IMPORTANT NOTES:
This Plan has been prepared for PEET FLAGSTONE CITY PTY LTD to Logan City standards, for the purpose of recording the As Constructed details of a new service constructed under a specific Council Approval and should not be used for any other purpose.

No report is made on any other services, nor any services that may exist before or be constructed after, the time of survey, or constructed under any other approval.

The property boundaries, easements and lot numbers shown hereon may be proposed only and subject to registration by the Department of Natural Resources. All property information should be determined from the registered Survey Plans.

All dimensions should be verified and confirmed against the latest information prior to commencement by any person using this plan for building purposes.

Veris Australia Pty Ltd accepts no responsibility for any changes made to construction or otherwise, after the date of this plan. Any discrepancies should be clarified in writing with the relevant Authority prior to commencement of the work.

Copyright © Veris Australia Pty Ltd. March 2025.

THESE DESIGNS AND DRAWINGS ARE COPYRIGHT AND ARE NOT TO BE USED OR REPRODUCED WITHOUT THE WRITTEN PERMISSION OF VERIS


Data Sources 30 109-LC-Master(DP) F894 2014.dwg

Cadastral Boundaries As-con survey Veris
Engineering Design COLLIER'S

B	Progress Plot	17.03.2025	JMc
A	Progress Plot	05.03.2025	JMc
Issue	Revisions	Date	Drawn

Local Authority: LCC
Horizontal Meridian: MGA
Vertical Level Datum: AHD D
Level Origin: PM107142(RL39.078)
Scale: 1:250 @ A1
Surveyed: HA
Designed: COLLIER'S
Drawn: JMc
Checked: JMc
Plot Date: 17 Mar, 2025
Computer File Ref: 430109-13071-ASW01-B LOCAL.dwg


AS-CONSTRUCTED
STORMWATER

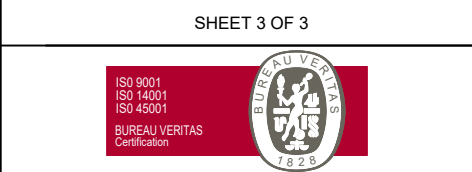

veris

BRISBANE (07) 3686 4700 WHITSUNDAYS (07) 4945 6600
MACKAY (07) 4951 9100 CAIRNS (07) 4232 9400

veris.com.au
ACN 615 735 727
Veris Australia Pty Ltd

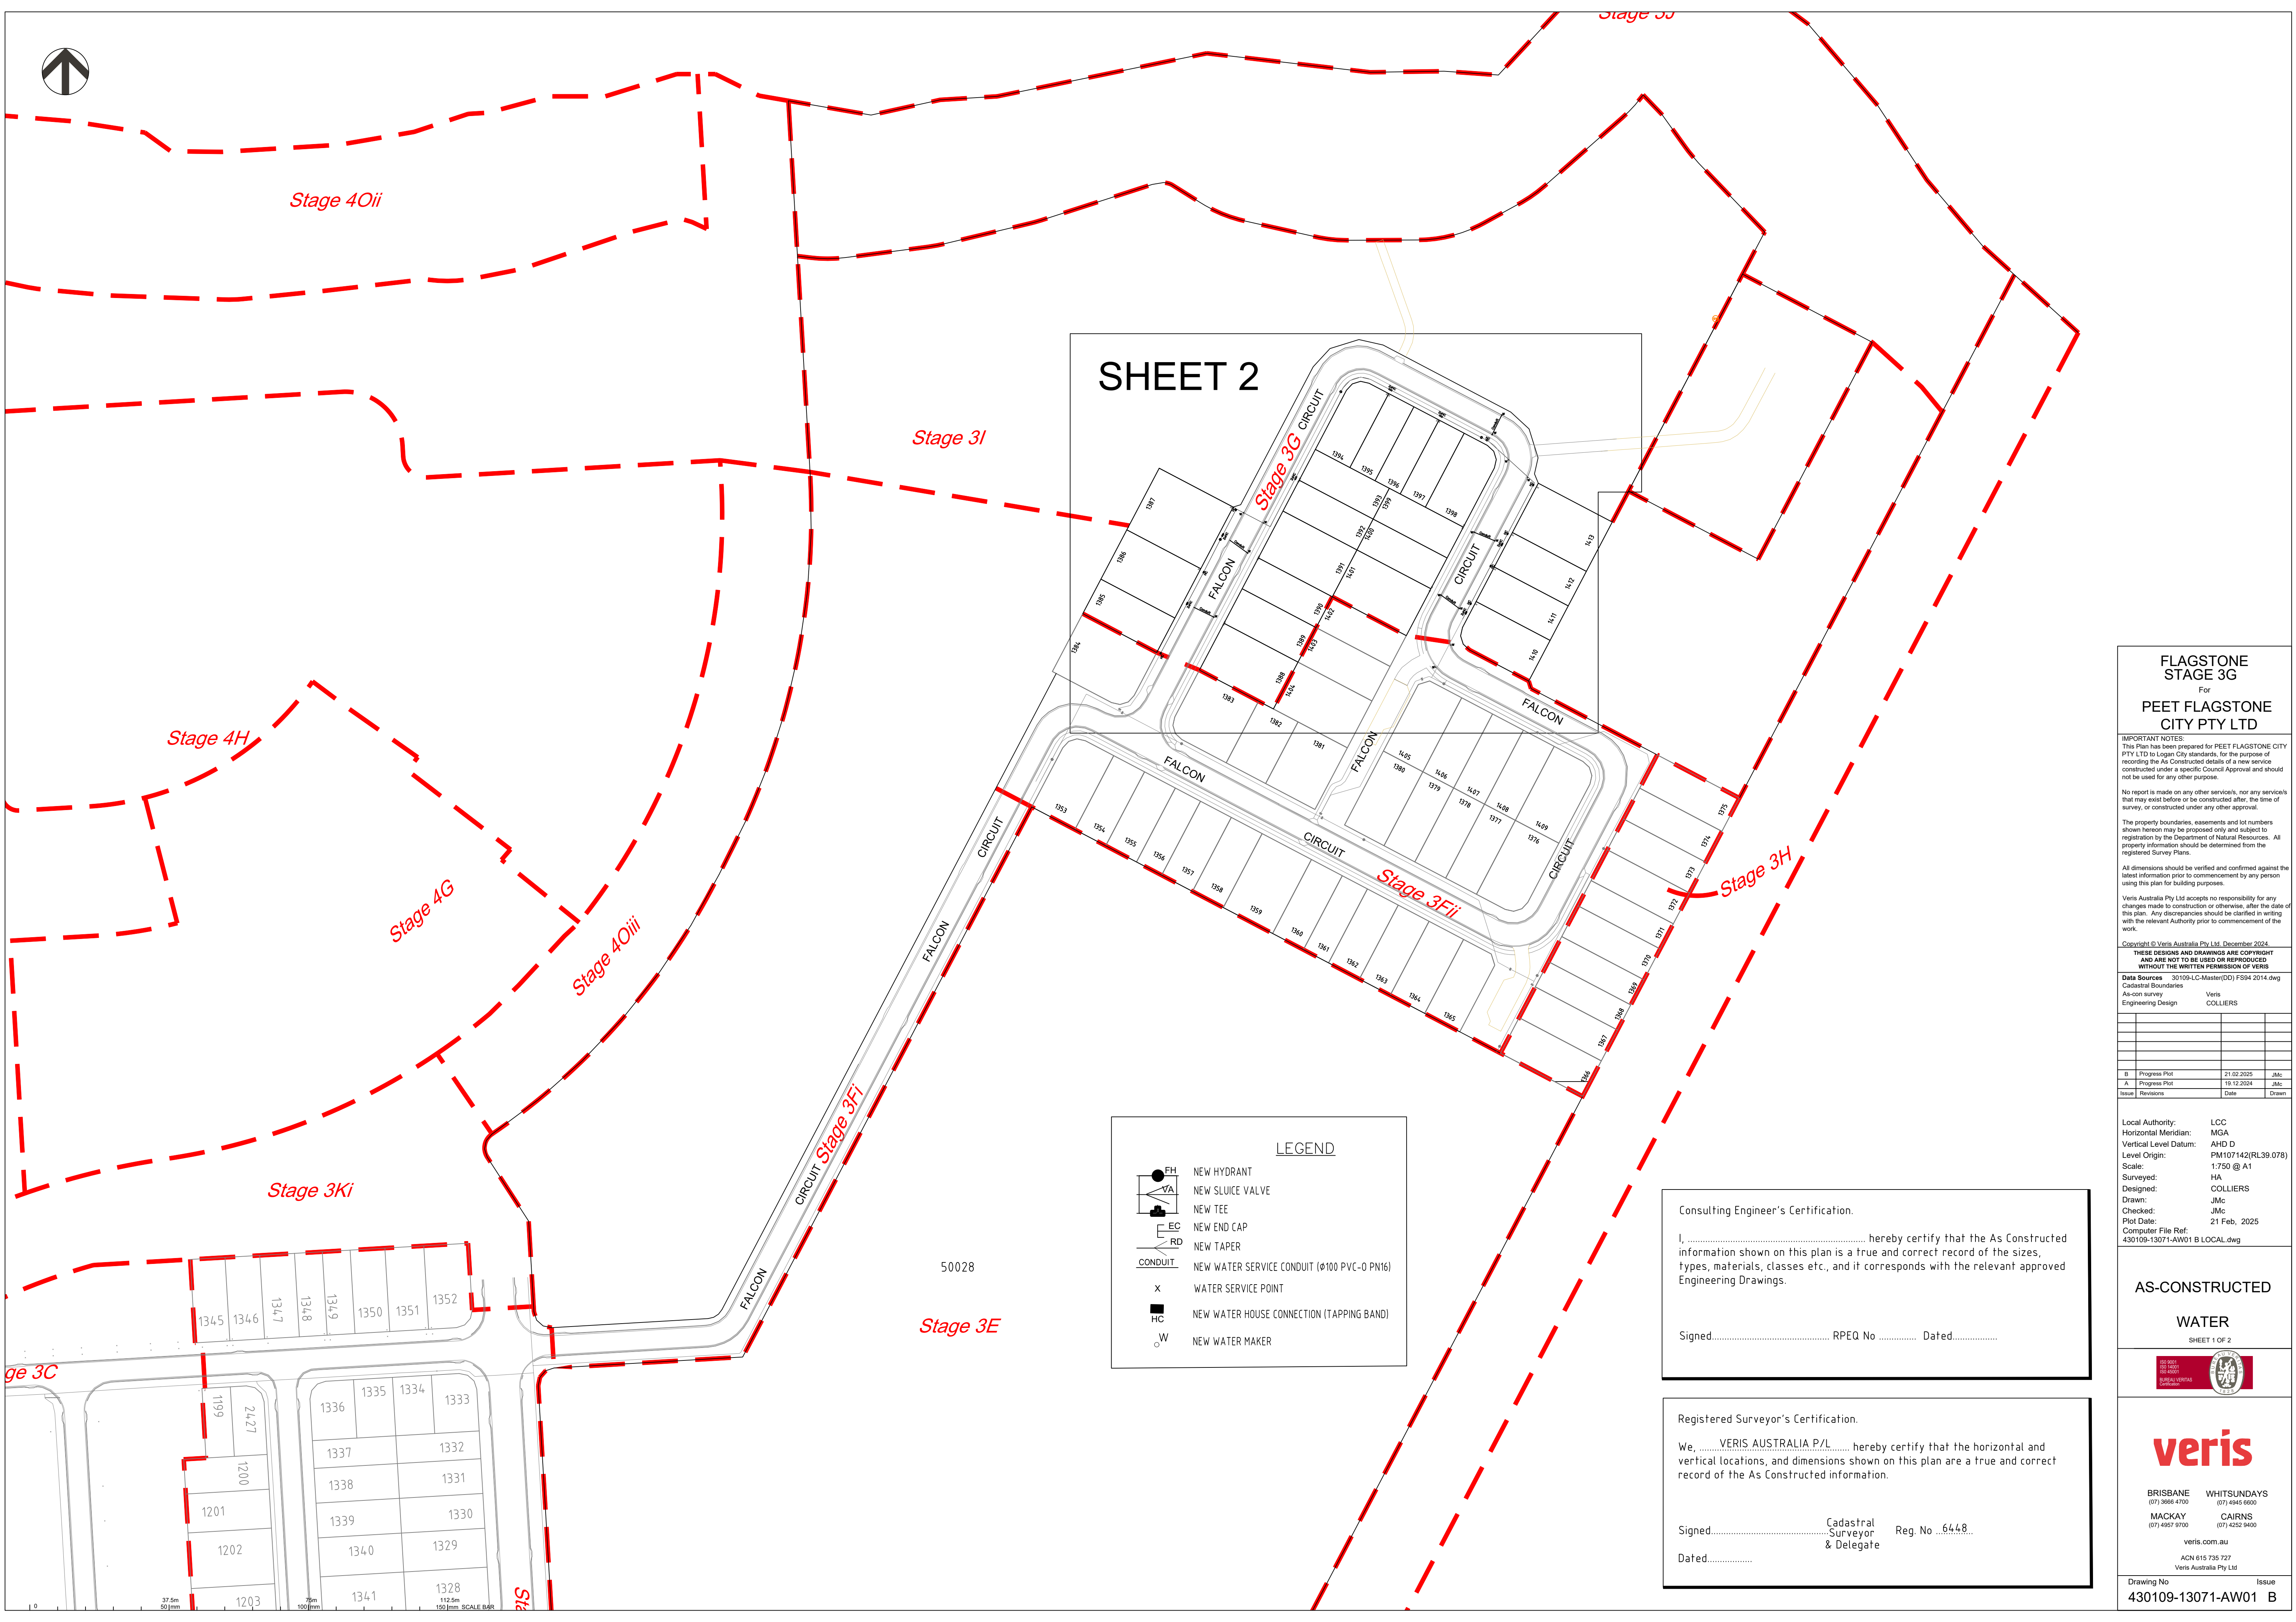

CITY PTY LTD

Plans should be verified and confirmed against the information prior to commencement by any person other than the planning officer responsible for the plan for building purposes.

Malta Pty Ltd accepts no responsibility for any errors made to construction or otherwise, after the date of completion of the plans.

Any discrepancies should be clarified in writing to the relevant Authority prior to commencement of the construction.

DESIGNS AND DRAWINGS ARE COPYRIGHT
ARE NOT TO BE USED OR REPRODUCED
OUT THE WRITTEN PERMISSION OF VERIS

Survey
Design
Veris
COLLIERS

Authority: LCC
 Al Meridian: MGA
 Level Datum: AHD D
 Origin: PM107142(RL39.078)
 1:750 @ A1
 HA
 COLLIERIES
 JMc
 JMc
 21 Feb, 2025
 For File Ref:
 3071-AW01 B LOCAL.dwg

SHEET 1 OF 2

Veris Australia Pty Ltd

109-13071-AW01 B

Stage 3/

Stage 2

LEGEND



NEW HYDRANT
NEW SLUICE VALVE
NEW TEE
NEW END CAP
NEW TAPER
NEW WATER SERVICE
WATER SERVICE PO
NEW WATER HOUSE
NEW WATER MAKER

Consulting Engineer's Certification.

..... hereby certify that the As Constructed information shown on this plan is a true and correct record of the sizes, types, materials, classes etc., and it corresponds with the relevant approved Engineering Drawings.

Signed..... RPEQ No Dated.....

Registered Surveyor's Certification.

We, VERIS AUSTRALIA P/L hereby certify that the horizontal and vertical locations, and dimensions shown on this plan are a true and correct record of the As Constructed information.

Signed..... Cadastral
Surveyor Req. No 6448

Dated.....



Consulting Engineer's Certification.

I, hereby certify that the As Constructed information shown on this plan is a true and correct record of the sizes, types, materials, classes etc., and it corresponds with the relevant approved Engineering Drawings.

Signed..... RPEQ No Dated.....

Registered Surveyor's Certification.

We, ..VERIS AUSTRALIA P/L..... hereby certify that the horizontal and vertical locations, and dimensions shown on this plan are a true and correct record of the As Constructed information.

Signed..... Cadastral Surveyor & Delegate Reg. No ...6448...

Dated.....

LEGEND

NEW HYDRANT

NEW SLUICE VALVE

NEW TEE

NEW END CAP


NEW TAPER

NEW WATER SERVICE CONDUIT (Ø100 PVC-O PN16)

WATER SERVICE POINT

NEW WATER HOUSE CONNECTION (TAPPING BAND)

NEW WATER MAKER

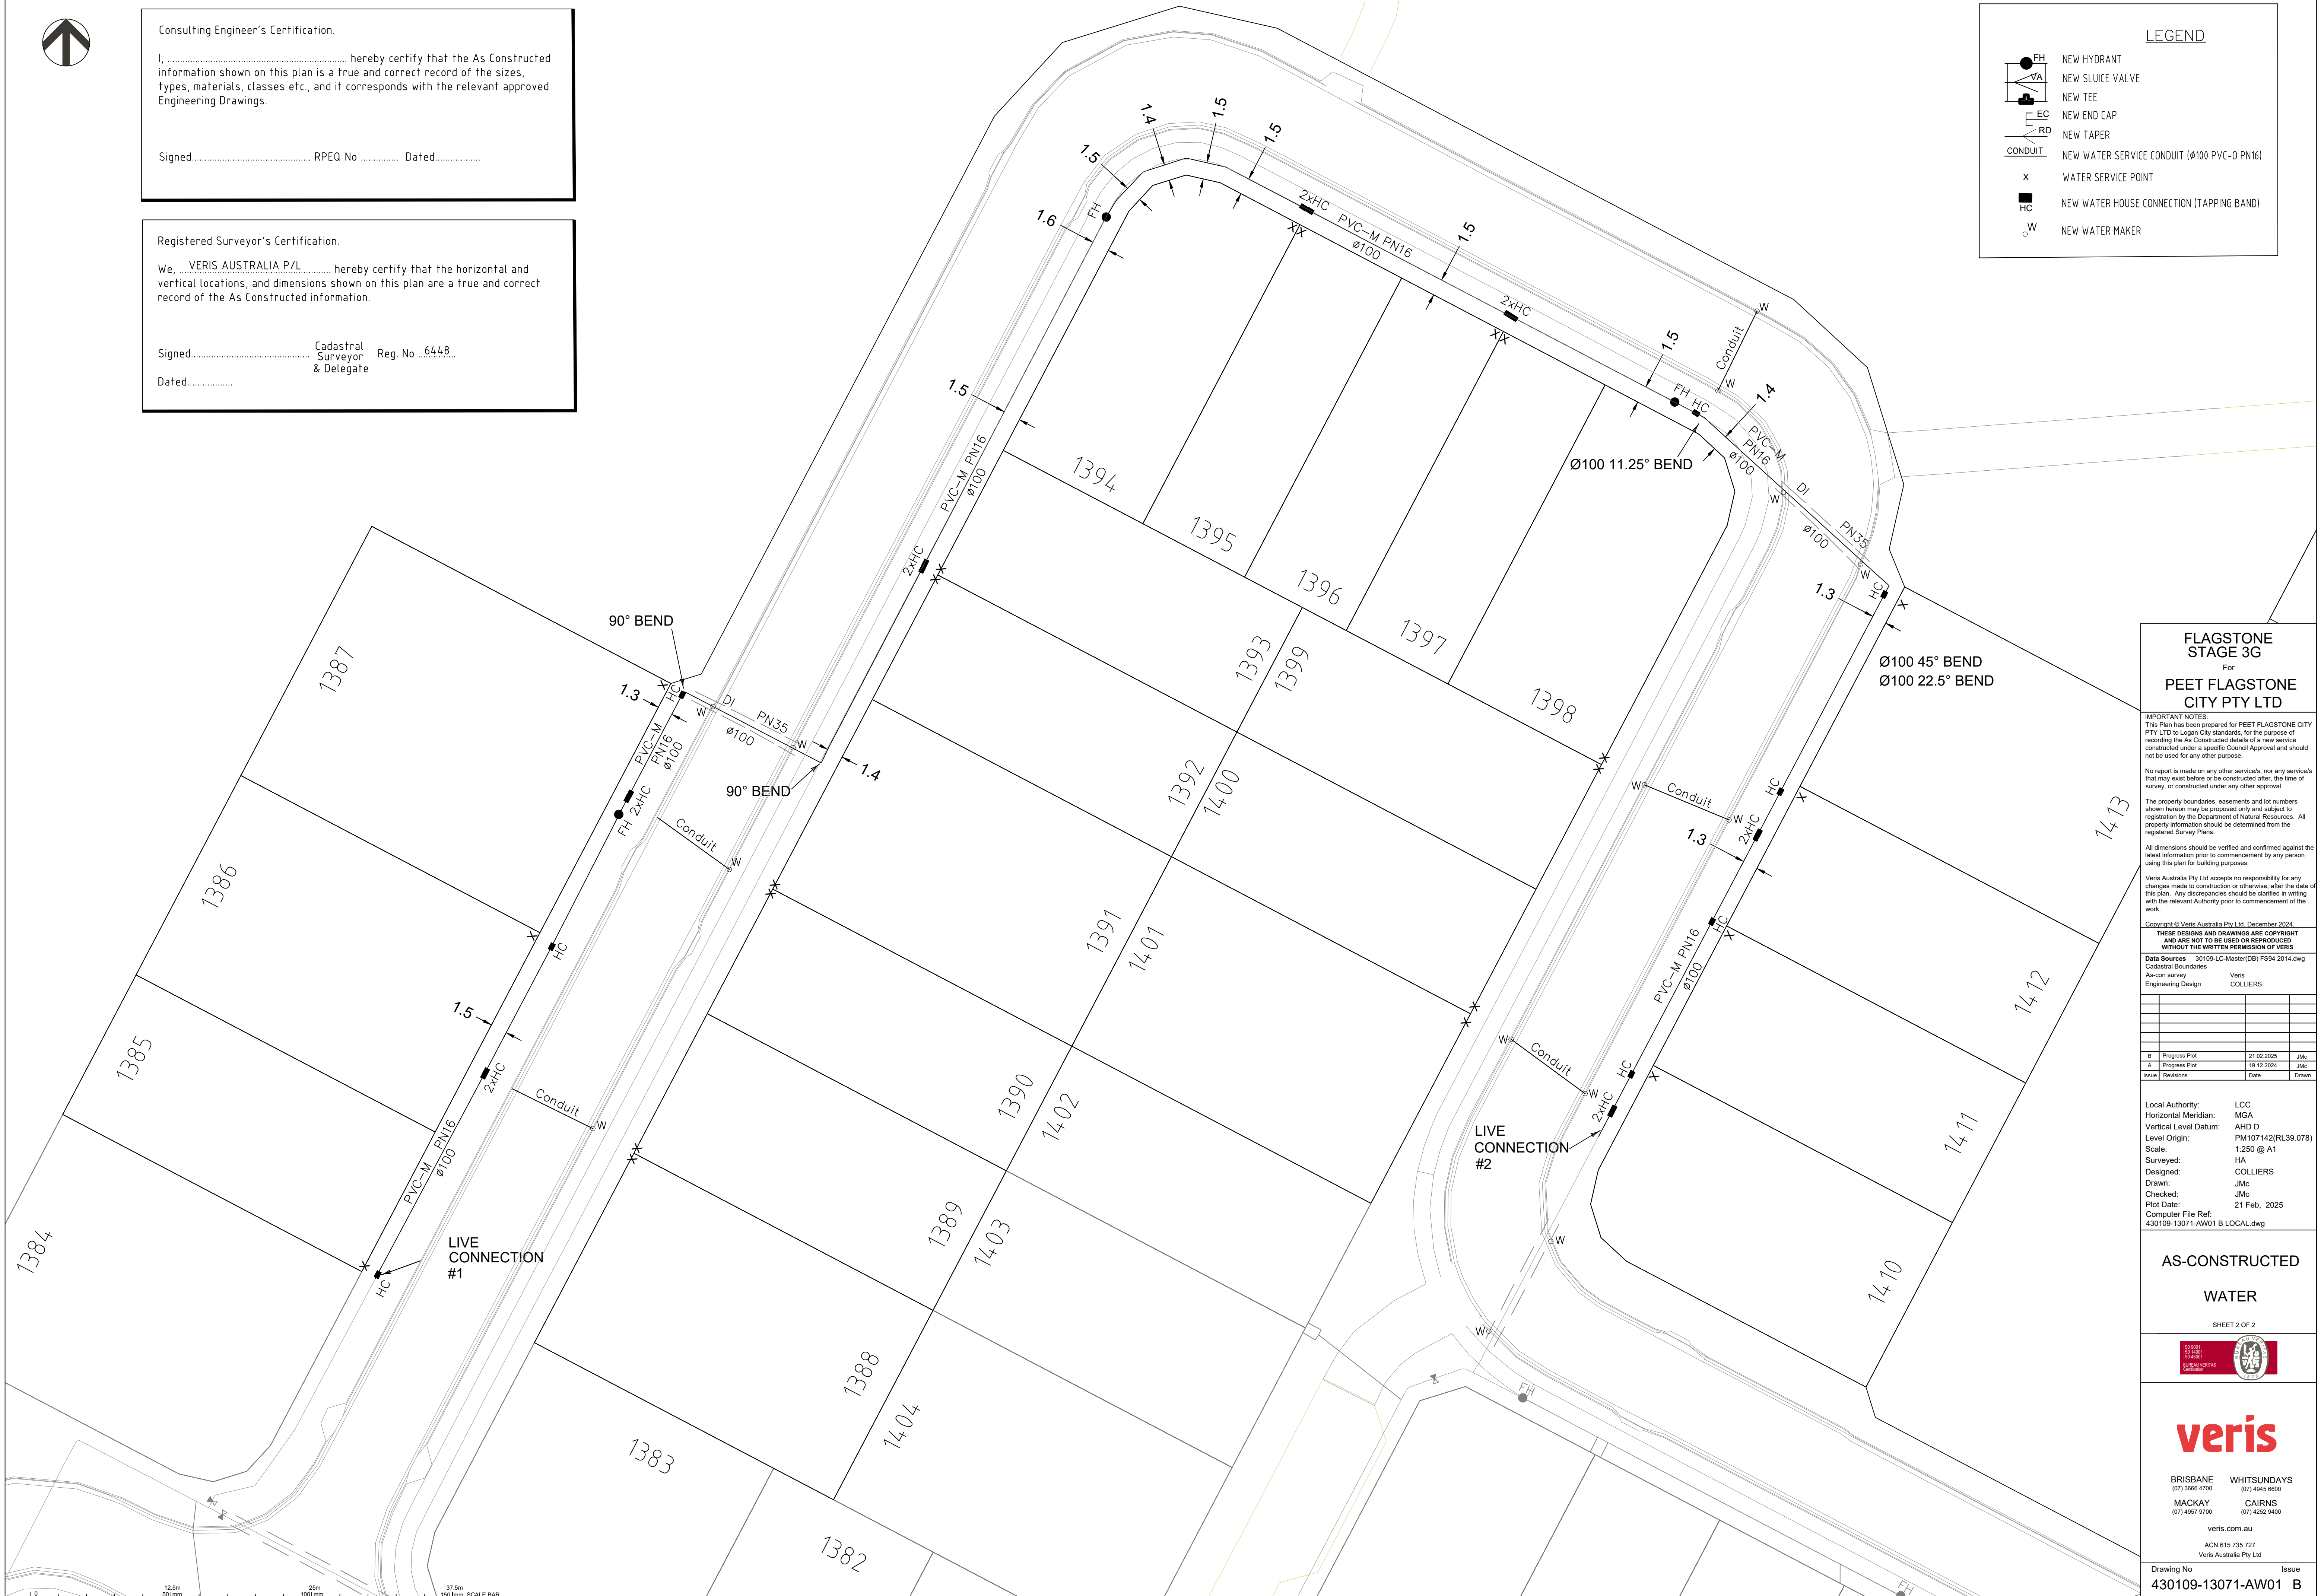

FLAGSTONE
STAGE 3G
For
PEET FLAGSTONE
CITY PTY LTD

IMPORTANT NOTES:
This Plan has been prepared for PEET FLAGSTONE CITY PTY LTD to Logon City standards, for the purpose of recording the As Constructed details of a new service constructed under a specific Council Approval and should not be used for any other purpose.

No report is made on any other service/s, nor any service/s that may exist before or be constructed after, the time of survey, or constructed under any other approval.

The property boundaries, easements and lot numbers shown hereon may be proposed only and subject to registration by the Department of Natural Resources. All property information should be determined from the registered Survey Plans.

All dimensions should be verified and confirmed against the latest information prior to commencement by any person using this plan for building purposes.

Veris Australia Pty Ltd accepts no responsibility for any changes made to construction or otherwise, after the date of this plan. Any discrepancies should be clarified in writing with the relevant Authority prior to commencement of the work.

Copyright © Veris Australia Pty Ltd. December 2024.

THESE DESIGNS AND DRAWINGS ARE COPYRIGHT AND ARE NOT TO BE USED OR REPRODUCED WITHOUT THE WRITTEN PERMISSION OF VERIS


Data Sources 30 109-LC-Master(DB) F594 2014.dwg

Cadastral Boundaries As-con survey Veris
Engineering Design COLLIERS

B	Progress Plot	21.02.2025	JMc
A	Progress Plot	18.12.2024	JMc
Issue	Revisions	Date	Drawn

Local Authority: LCC
Horizontal Meridian: MGA
Vertical Level Datum: AHD D
Level Origin: PM107142(RL39.078)
Scale: 1:250 @ A1
Surveyed: HA
Designed: COLLIERS
Drawn: JMc
Checked: JMc
Plot Date: 21 Feb, 2025
Computer File Ref: 430109-13071-AW01 B LOCAL.dwg


AS-CONSTRUCTED
WATER

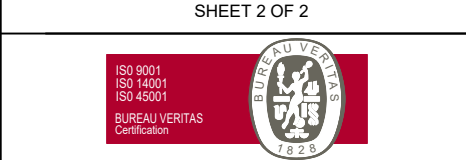

BRISBANE (07) 3666 4700 WHITSUNDAYS (07) 4945 6600
MACKAY (07) 4951 9100 CAIRNS (07) 4232 9400

veris.com.au
ACN 615 735 727
Veris Australia Pty Ltd

Drawing No Issue
430109-13071-AW01 B

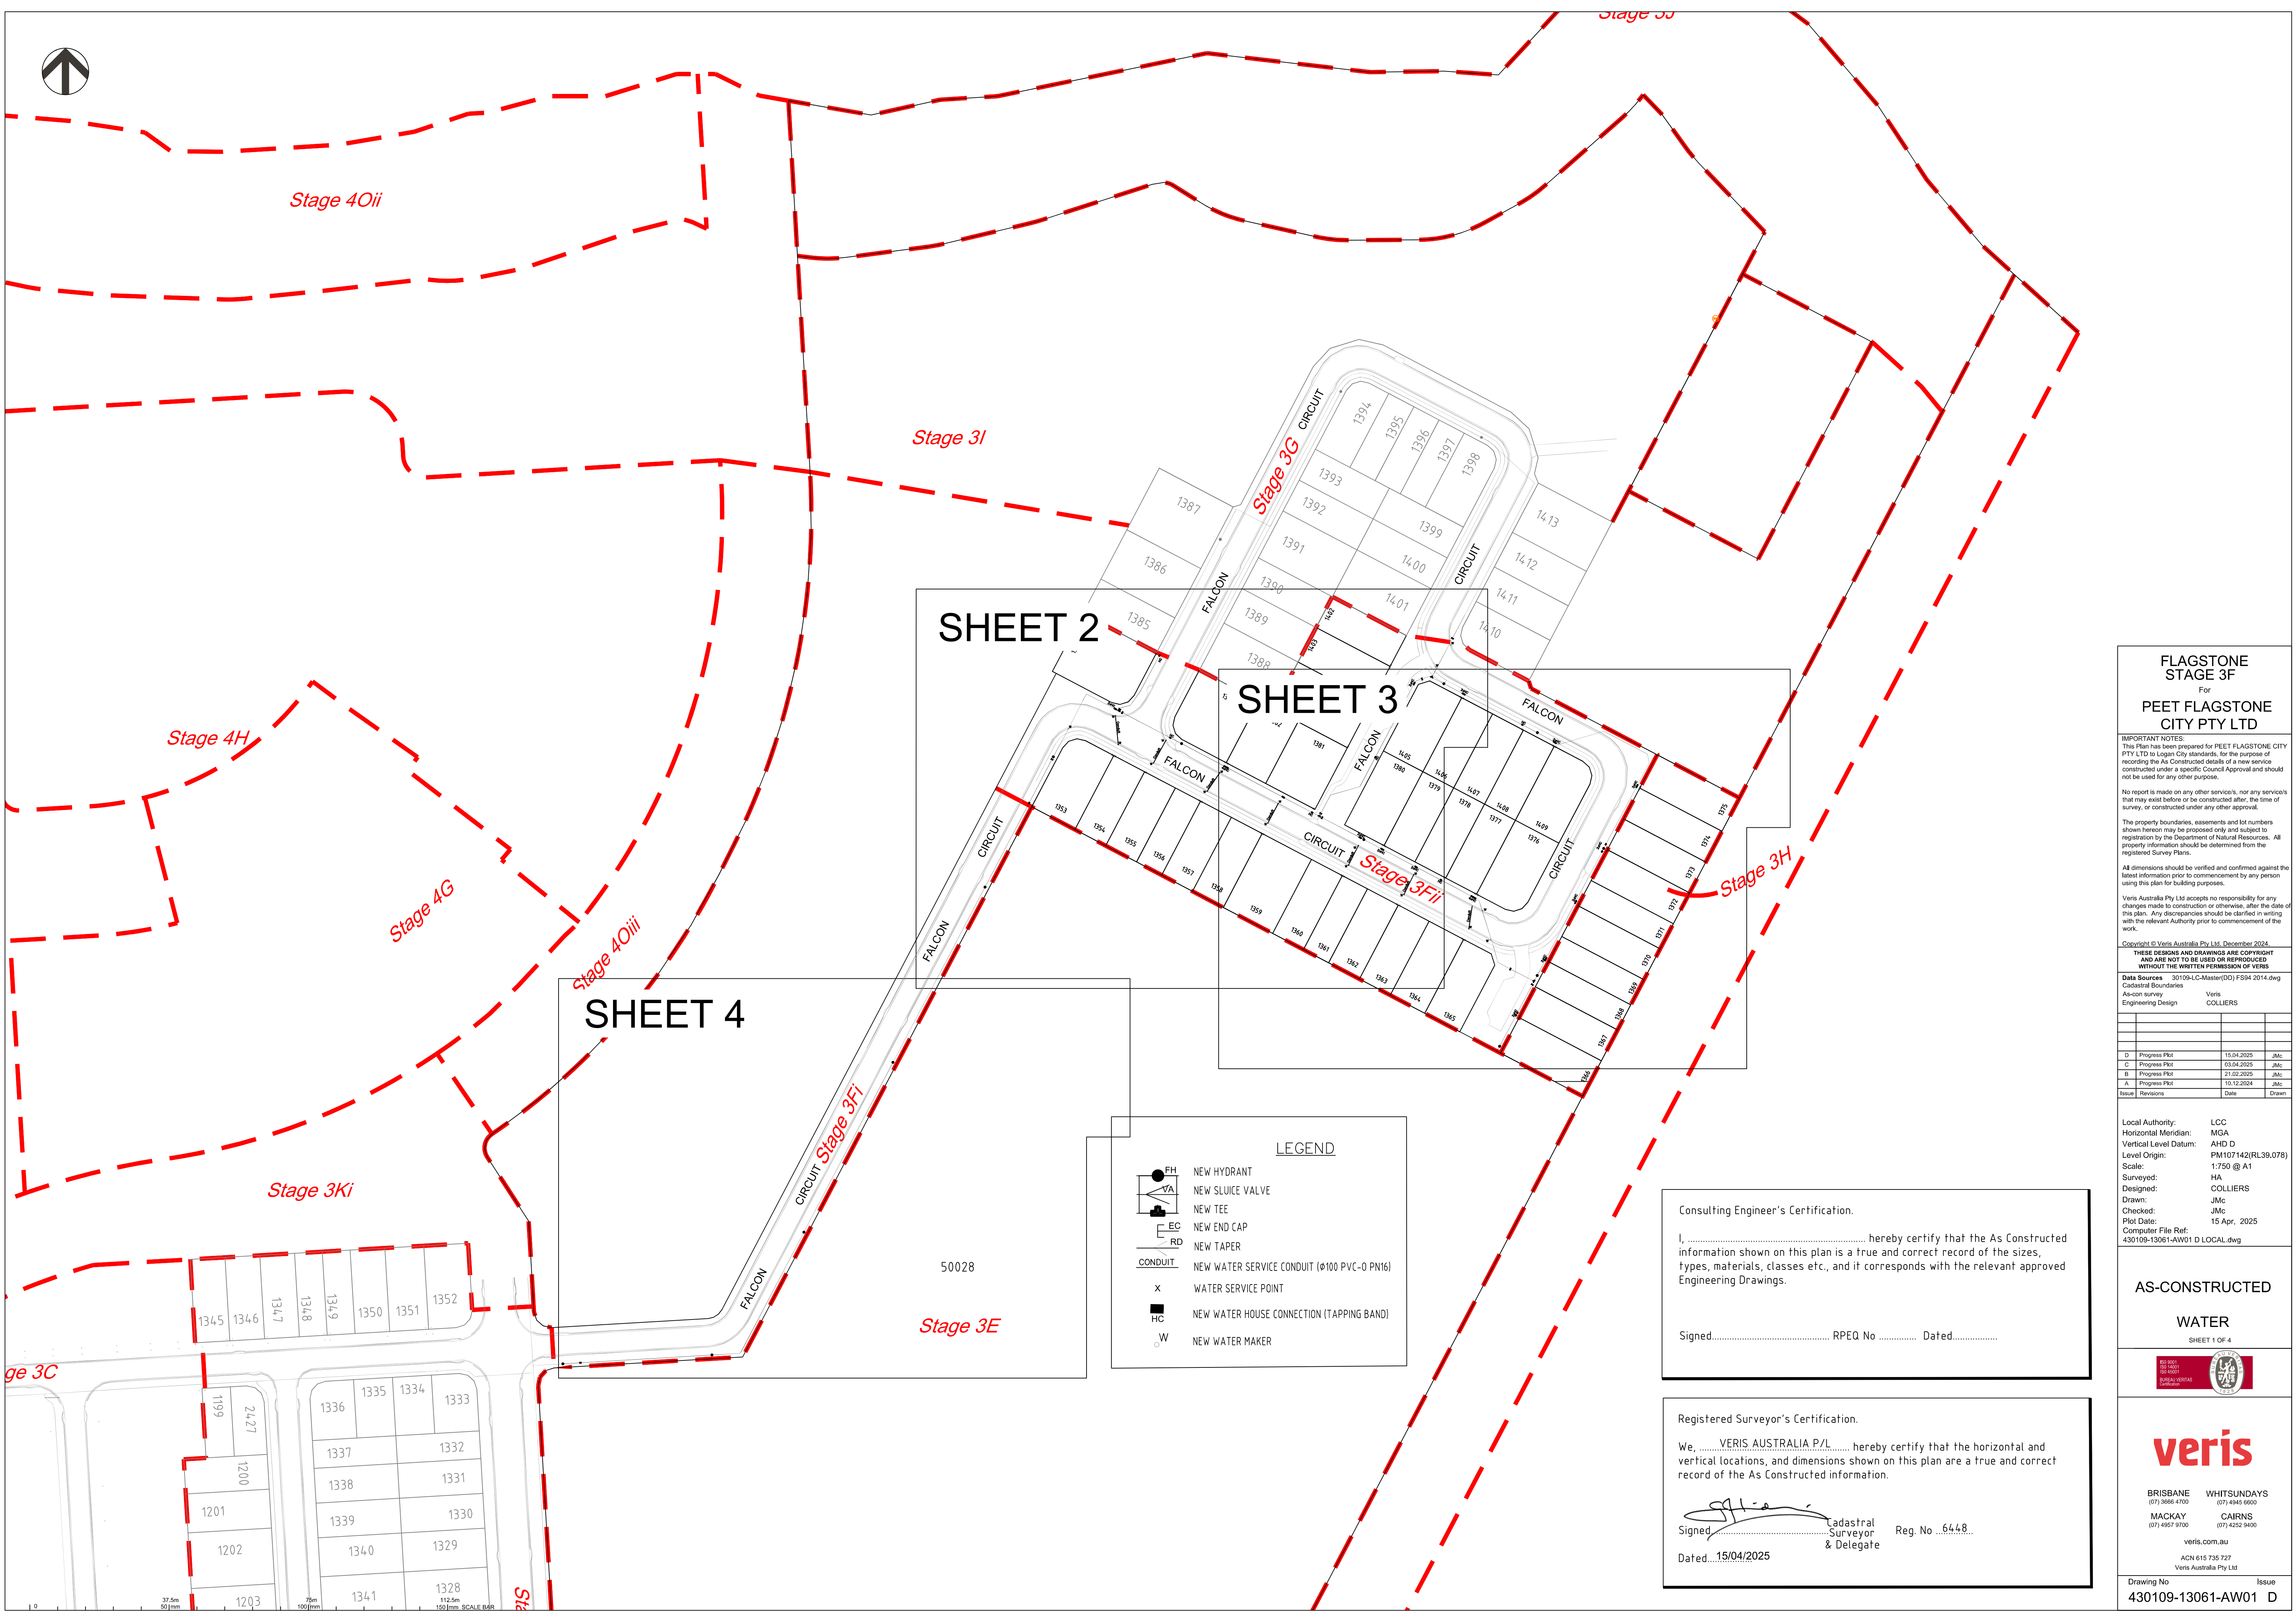

IMPORTANT NOTES:
This Plan has been prepared for PEET FLAGSTONE CITY
PTY LTD to Logan City standards, for the purpose of
recording the As Constructed details of a new service
constructed under a specific Council Approval and should
not be used for any other purpose.

No report is made on any other service/s, nor any service/s that may exist before or be constructed after, the time of survey, or constructed under any other approval.

The property boundaries, easements and lot numbers shown hereon may be proposed only and subject to registration by the Department of Natural Resources. All property information should be determined from the registered Survey Plans.

Veris Australia Pty Ltd accepts no responsibility for any changes made to construction or otherwise, after the date of this plan. Any discrepancies should be clarified in writing with the relevant Authority prior to commencement of the work.

Copyright © Veris Australia Pty Ltd, December 2024.

THESE DESIGNS AND DRAWINGS ARE COPYRIGHT
AND ARE NOT TO BE USED OR REPRODUCED
WITHOUT THE WRITTEN PERMISSION OF VERIS

Data Sources	30109-LC-Master(DD) FS94 2014.dwg
Cadastral Boundaries	
As-con survey	Veris
Engineering Design	COLLIERS


Local Authority: LCC
Horizontal Meridian: MGA
Vertical Level Datum: AHD D
Level Origin: PM107142(RL39.078)
Scale: 1:750 @ A1
Surveyed: HA
Designed: COLLIERS
Drawn: JMc
Checked: JMc
Plot Date: 15 Apr, 2025
Computer File Ref:
430109-13061-AW01 D LOCAL.dwg

SHEET 1 OF 4



veris.com.au

Drawing No	Issue
430109-13061-AW01	D

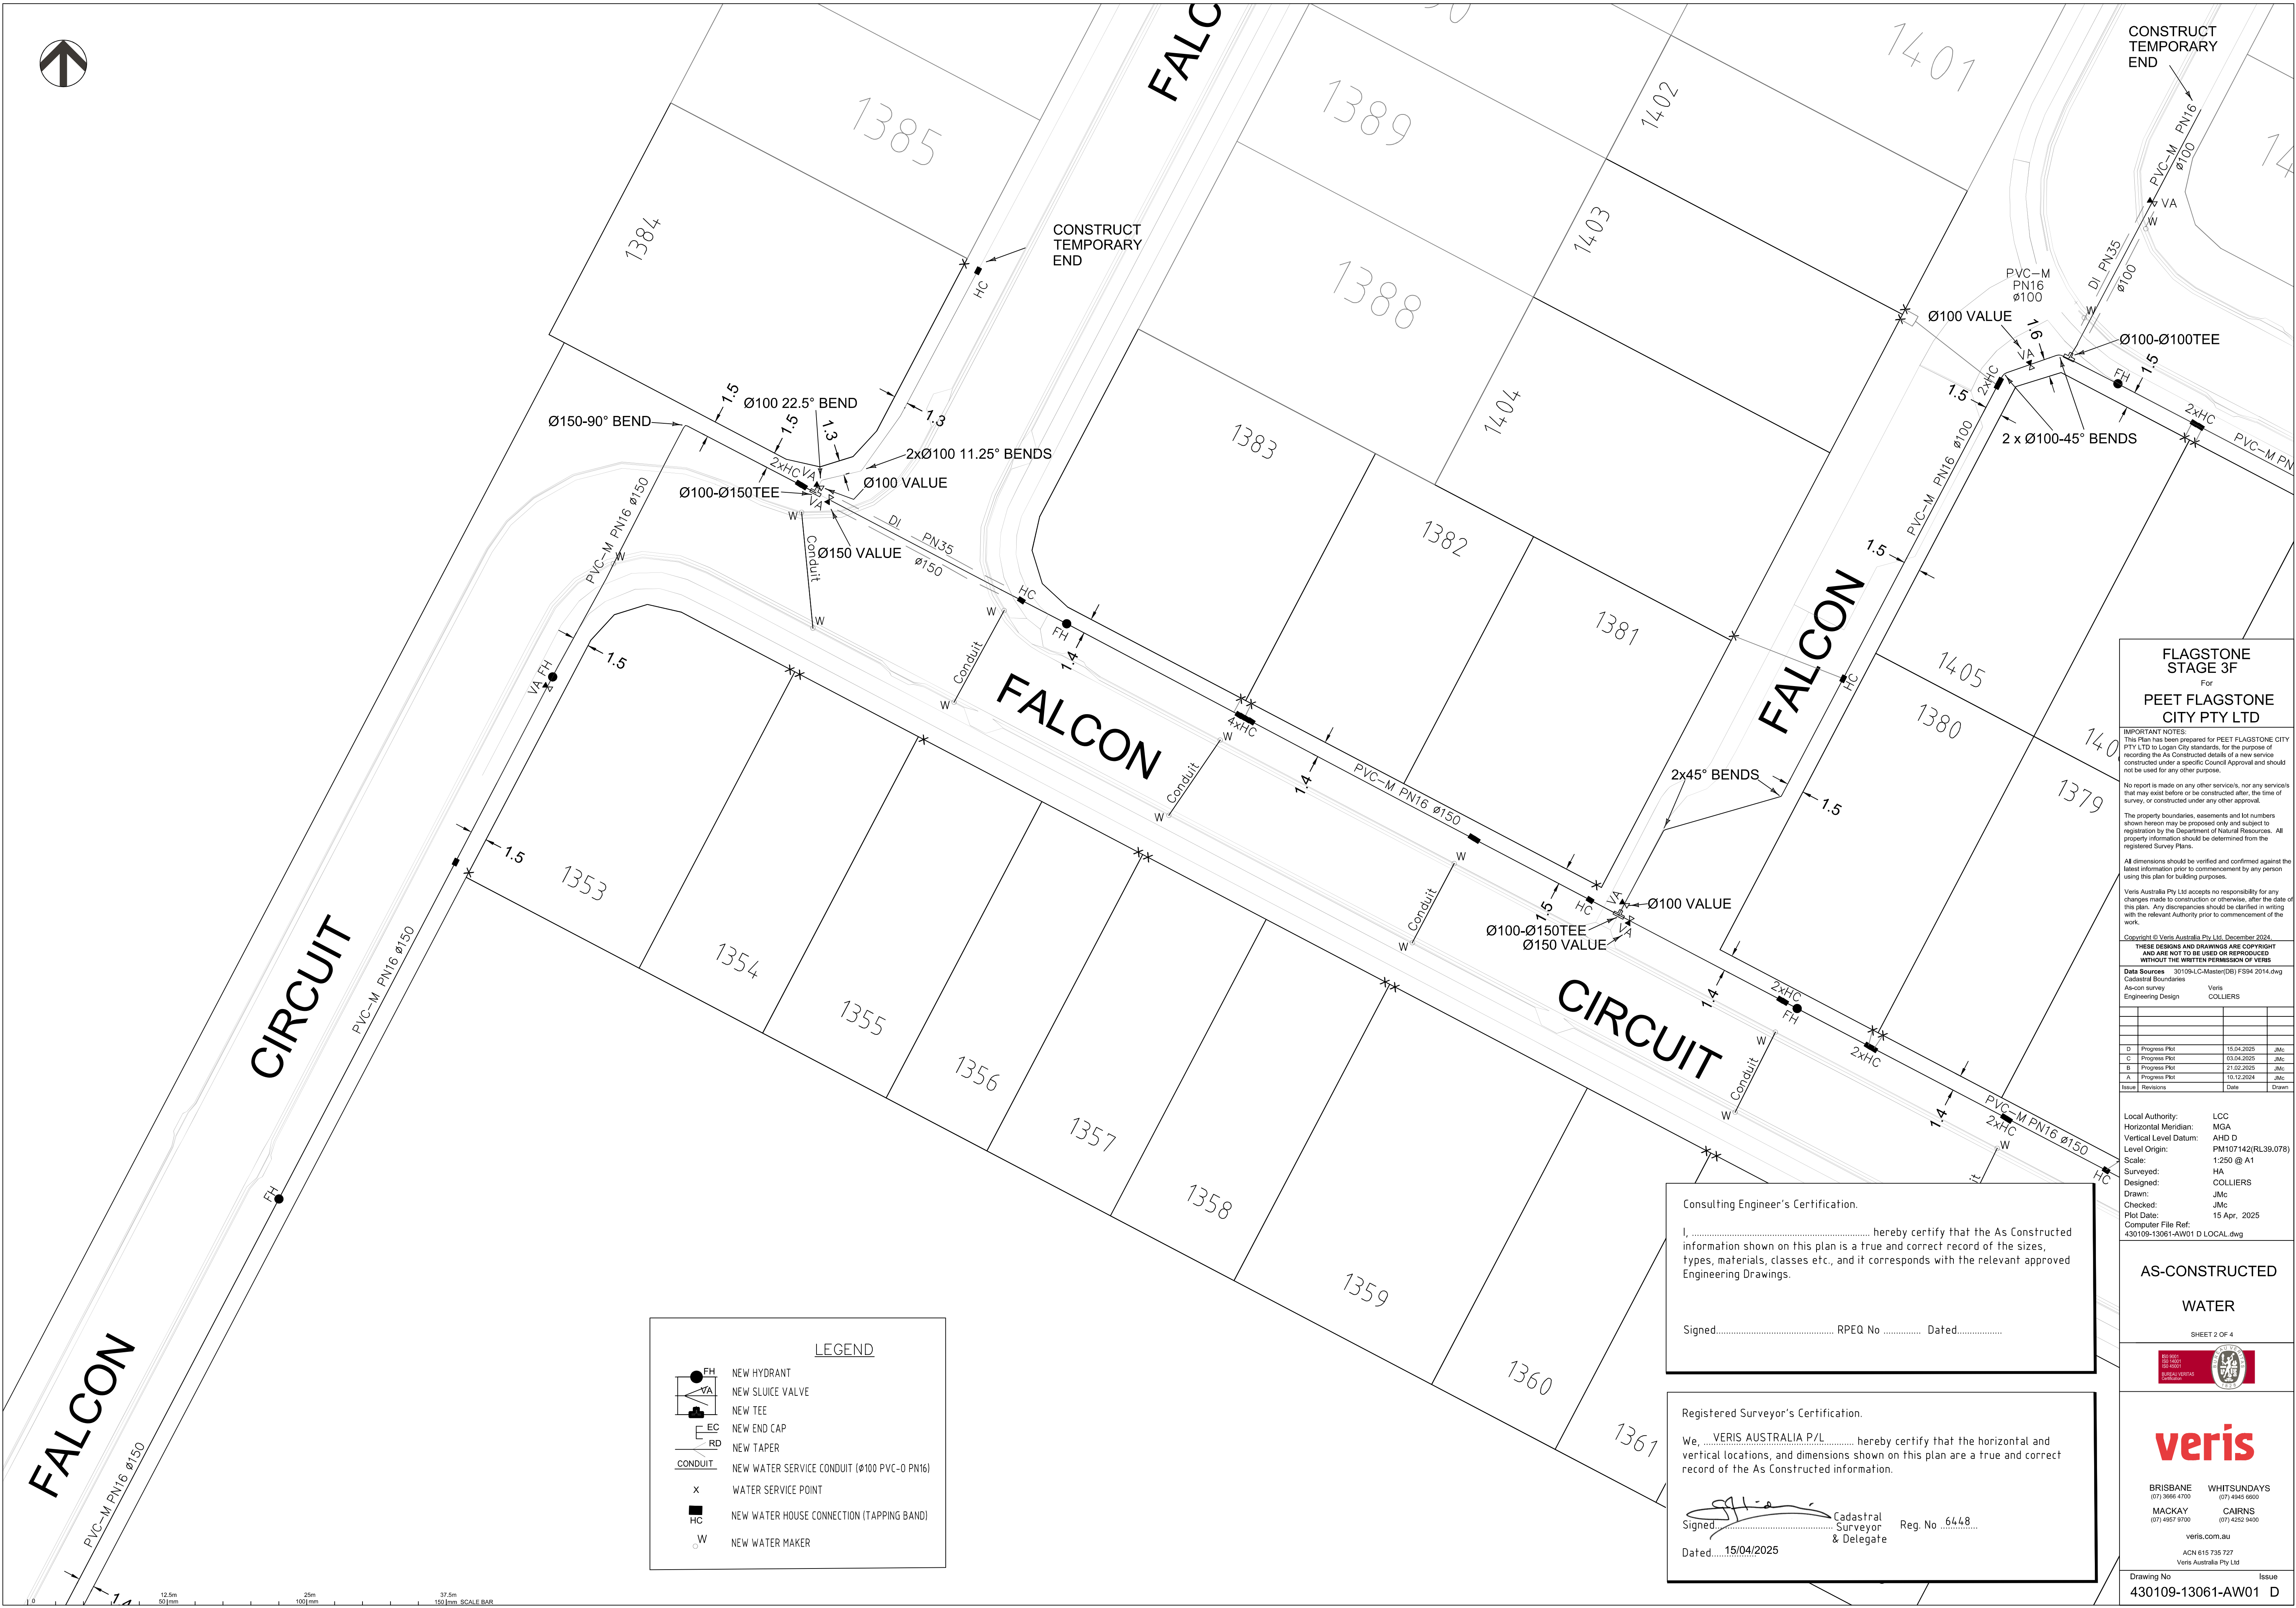

LEGEND

FH

VA

EC

RD

CONDUIT

X

HC

W

NEW HYDRANT

NEW SLUICE VALVE

NEW TEE

NEW END CAP

NEW TAPER

NEW WATER SERVICE CONDUIT (Ø100 PVC-O PN16)

WATER SERVICE POINT

NEW WATER HOUSE CONNECTION (TAPPING BAND)

NEW WATER MAKER

Consulting Engineer's Certification.

I, hereby certify that the As Constructed information shown on this plan is a true and correct record of the sizes, types, materials, classes etc., and it corresponds with the relevant approved Engineering Drawings.

Signed..... RPEQ No Dated.....

Registered Surveyor's Certification.

We, **VERIS AUSTRALIA P/L** hereby certify that the horizontal and vertical locations, and dimensions shown on this plan are a true and correct record of the As Constructed information.

Cadastral Surveyor & Delegate

Reg. No **6448**

Dated..... **15/04/2025**

FLAGSTONE STAGE 3F

For

PEET FLAGSTONE CITY PTY LTD

IMPORTANT NOTES:

This Plan has been prepared for PEET FLAGSTONE CITY PTY LTD to Logan City standards, for the purpose of recording the As Constructed details of a new service constructed under a specific Council Approval and should not be used for any other purpose.

No report is made on any other service's, nor any services that may exist before or be constructed after, the time of survey, or constructed under any other approval.

The property boundaries, easements and lot numbers shown hereon may be proposed only and subject to registration by the Department of Natural Resources. All property information should be determined from the registered Survey Plans.

All dimensions should be verified and confirmed against the latest information prior to commencement by any person using this plan for building purposes.

Veris Australia Pty Ltd accepts no responsibility for any changes made to construction or otherwise, after the date of this plan. Any discrepancies should be clarified in writing with the relevant Authority prior to commencement of the work.

Copyright © Veris Australia Pty Ltd. December 2024.

THESE DESIGNS AND DRAWINGS ARE COPYRIGHT AND ARE NOT TO BE USED OR REPRODUCED WITHOUT THE WRITTEN PERMISSION OF VERIS

Data Sources

30109-L-C-Master(D8) F594 2014.dwg

Cadastral Boundaries

As-con survey

Engineering Design

Veris

COLLIERS

D	Progress Plot	15.04.2025 JMc
C	Progress Plot	03.04.2025 JMc
B	Progress Plot	21.02.2025 JMc
A	Progress Plot	10.12.2024 JMc
Issue	Revisions	Date Drawn

Local Authority:

LCC

Horizontal Meridian:

MGA

Vertical Level Datum:

AHD D

Level Origin:

PM107142(RL39.078)

Scale:

1:250 @ A1

Surveyed:

HA

Designed:

COLLIERS

Drawn:

JMc

Checked:

JMc

Plot Date:

15 Apr. 2025

Computer File Ref:

430109-13061-AW01 D LOCAL.dwg

AS-CONSTRUCTED

WATER

SHEET 2 OF 4

BRISBANE

(07) 3666 4700

WHITSUNDAYS

(07) 4945 6600

MACKAY

(07) 4957 9100

CAIRNS

(07) 4232 9400

veris.com.au

ACN 615 735 727



Veris Australia Pty Ltd

Drawing No

430109-13061-AW01

Issue

D

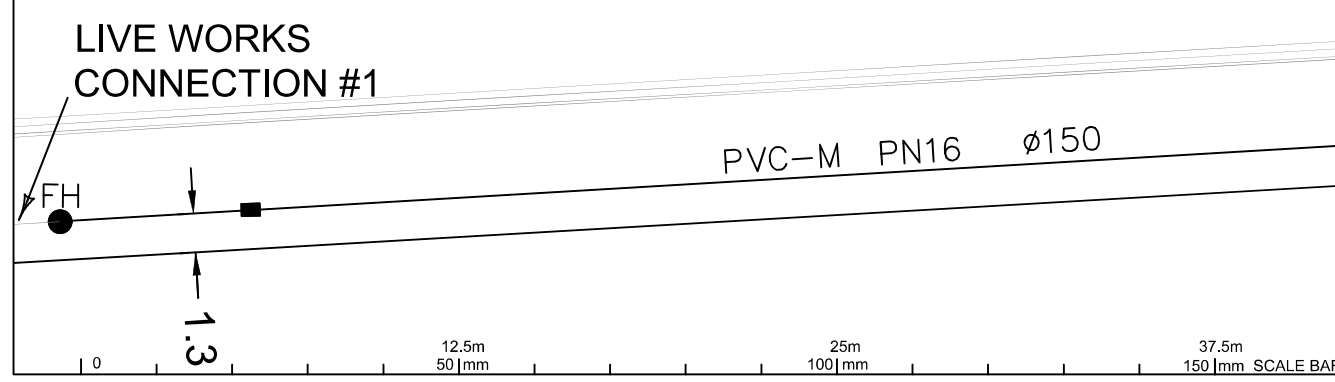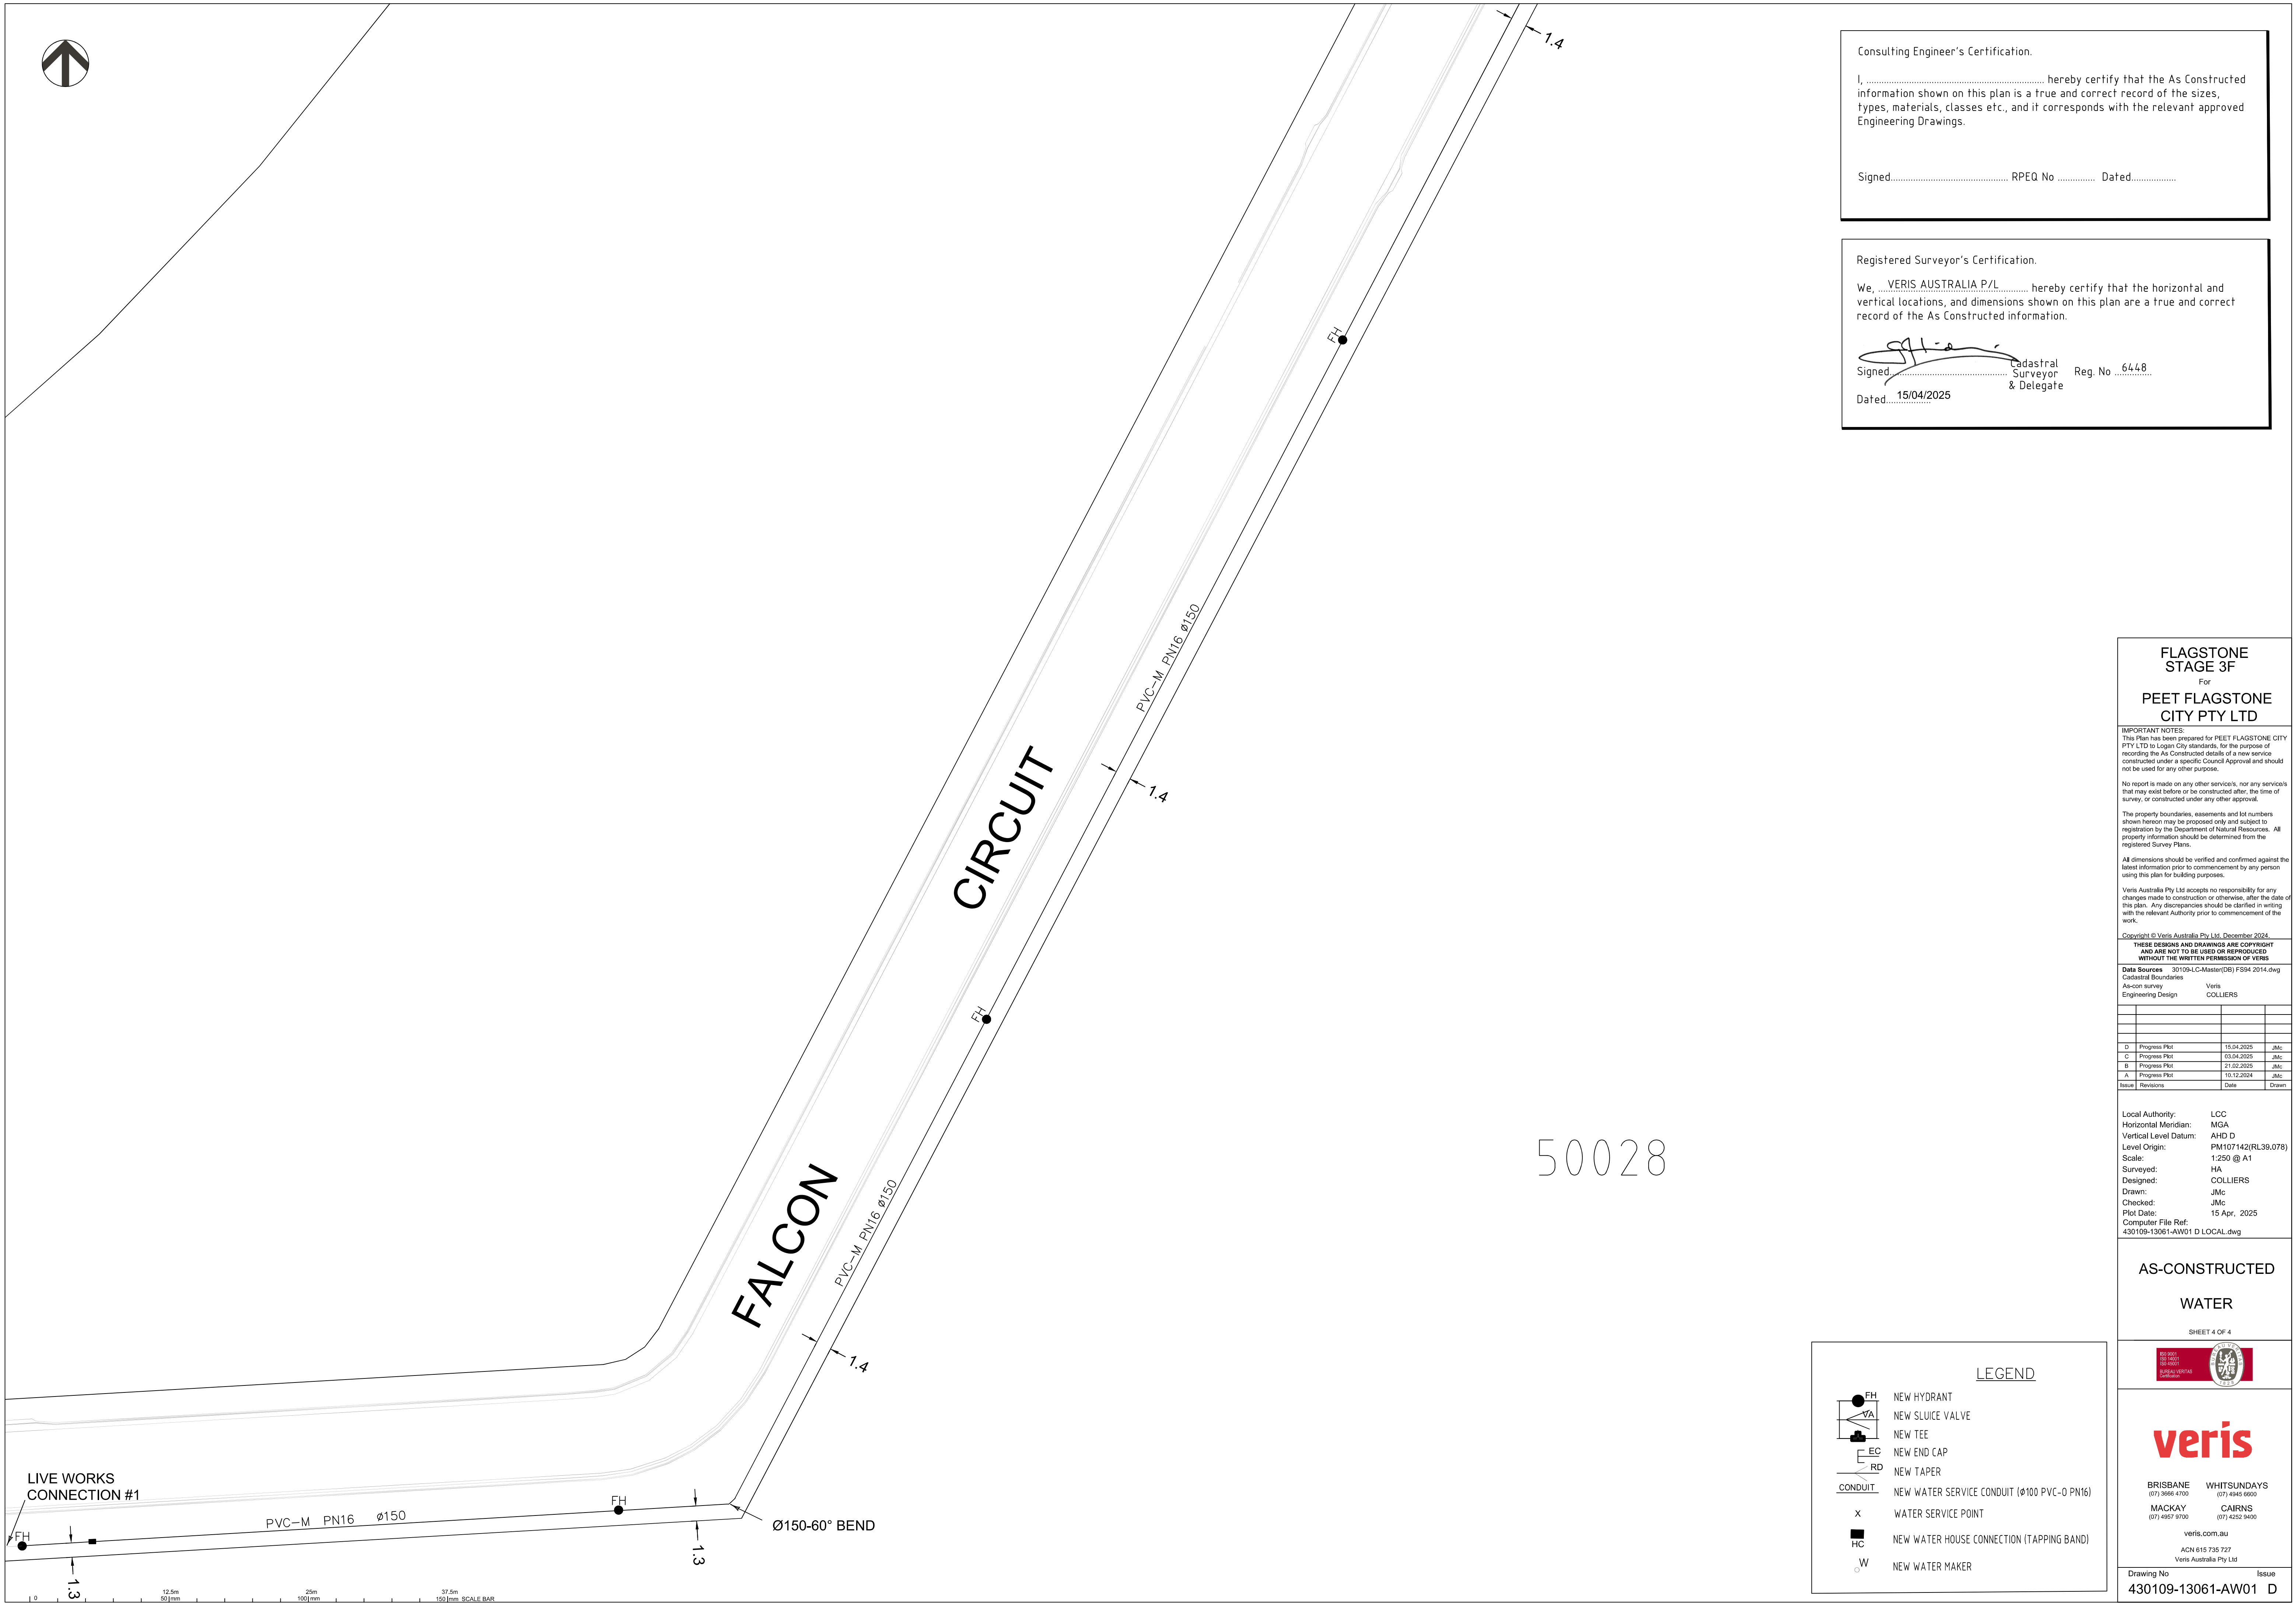

Consulting Engineer's Certification.

I, hereby certify that the As Constructed information shown on this plan is a true and correct record of the sizes, types, materials, classes etc., and it corresponds with the relevant approved Engineering Drawings.

Signed..... RPEQ No Dated.....

Registered Surveyor's Certification.

We, ...VERIS AUSTRALIA P/L..... hereby certify that the horizontal and vertical locations, and dimensions shown on this plan are a true and correct record of the As Constructed information.

Signed.....
Dated..... 15/04/2025

Cadastral Surveyor & Delegate
Reg. No ...6448

LEGEND

FH NEW HYDRANT
VA NEW SLUICE VALVE
EC NEW TEE
RD NEW END CAP
RD NEW TAPER
CONDUIT NEW WATER SERVICE CONDUIT (Ø100 PVC-O PN16)
X WATER SERVICE POINT
HC NEW WATER HOUSE CONNECTION (TAPPING BAND)
W NEW WATER MAKER

FLAGSTONE STAGE 3F
For
PEET FLAGSTONE CITY PTY LTD

IMPORTANT NOTES:
This Plan has been prepared for PEET FLAGSTONE CITY PTY LTD to Logan City standards, for the purpose of recording the As Constructed details of a new service constructed under a specific Council Approval and should not be used for any other purpose.
No report is made on any other service's, nor any services that may exist before or be constructed after, the time of survey, or constructed under any other approval.
The property boundaries, easements and lot numbers shown hereon may be proposed only and subject to registration by the Department of Natural Resources. All property information should be determined from the registered Survey Plans.
All dimensions should be verified and confirmed against the latest information prior to commencement by any person using this plan for building purposes.
Veris Australia Pty Ltd accepts no responsibility for any changes made to construction or otherwise, after the date of this plan. Any discrepancies should be clarified in writing with the relevant Authority prior to commencement of the work.
Copyright © Veris Australia Pty Ltd, December 2024.
THESE DESIGNS AND DRAWINGS ARE COPYRIGHT AND ARE NOT TO BE USED OR REPRODUCED WITHOUT THE WRITTEN PERMISSION OF VERIS
Data Sources : 30109-LC-Master(D8) F894 2014.dwg
Cadastral Boundaries :
As-con survey : Veris
Engineering Design : COLLIERS

D	Progress Plot	15.04.2025	JMc
C	Progress Plot	03.04.2025	JMc
B	Progress Plot	21.02.2025	JMc
A	Progress Plot	10.12.2024	JMc
Issue	Revisions	Date	Drawn

Local Authority: LCC
Horizontal Meridian: MGA
Vertical Level Datum: AHD D
Level Origin: PM107142(RL39.078)
Scale: 1:250 @ A1
Surveyed: HA
Designed: COLLIERS
Drawn: JMc
Checked: JMc
Plot Date: 15 Apr, 2025
Computer File Ref: 430109-13061-AW01 D LOCAL.dwg

AS-CONSTRUCTED WATER


SHEET 4 OF 4

veris

BRISBANE (07) 3666 4700 WHITSUNDAYS (07) 4945 6600
MACKAY (07) 4957 9100 CAIRNS (07) 4232 9400

veris.com.au
ACN 615 735 727
Veris Australia Pty Ltd

Drawing No 430109-13061-AW01 D Issue

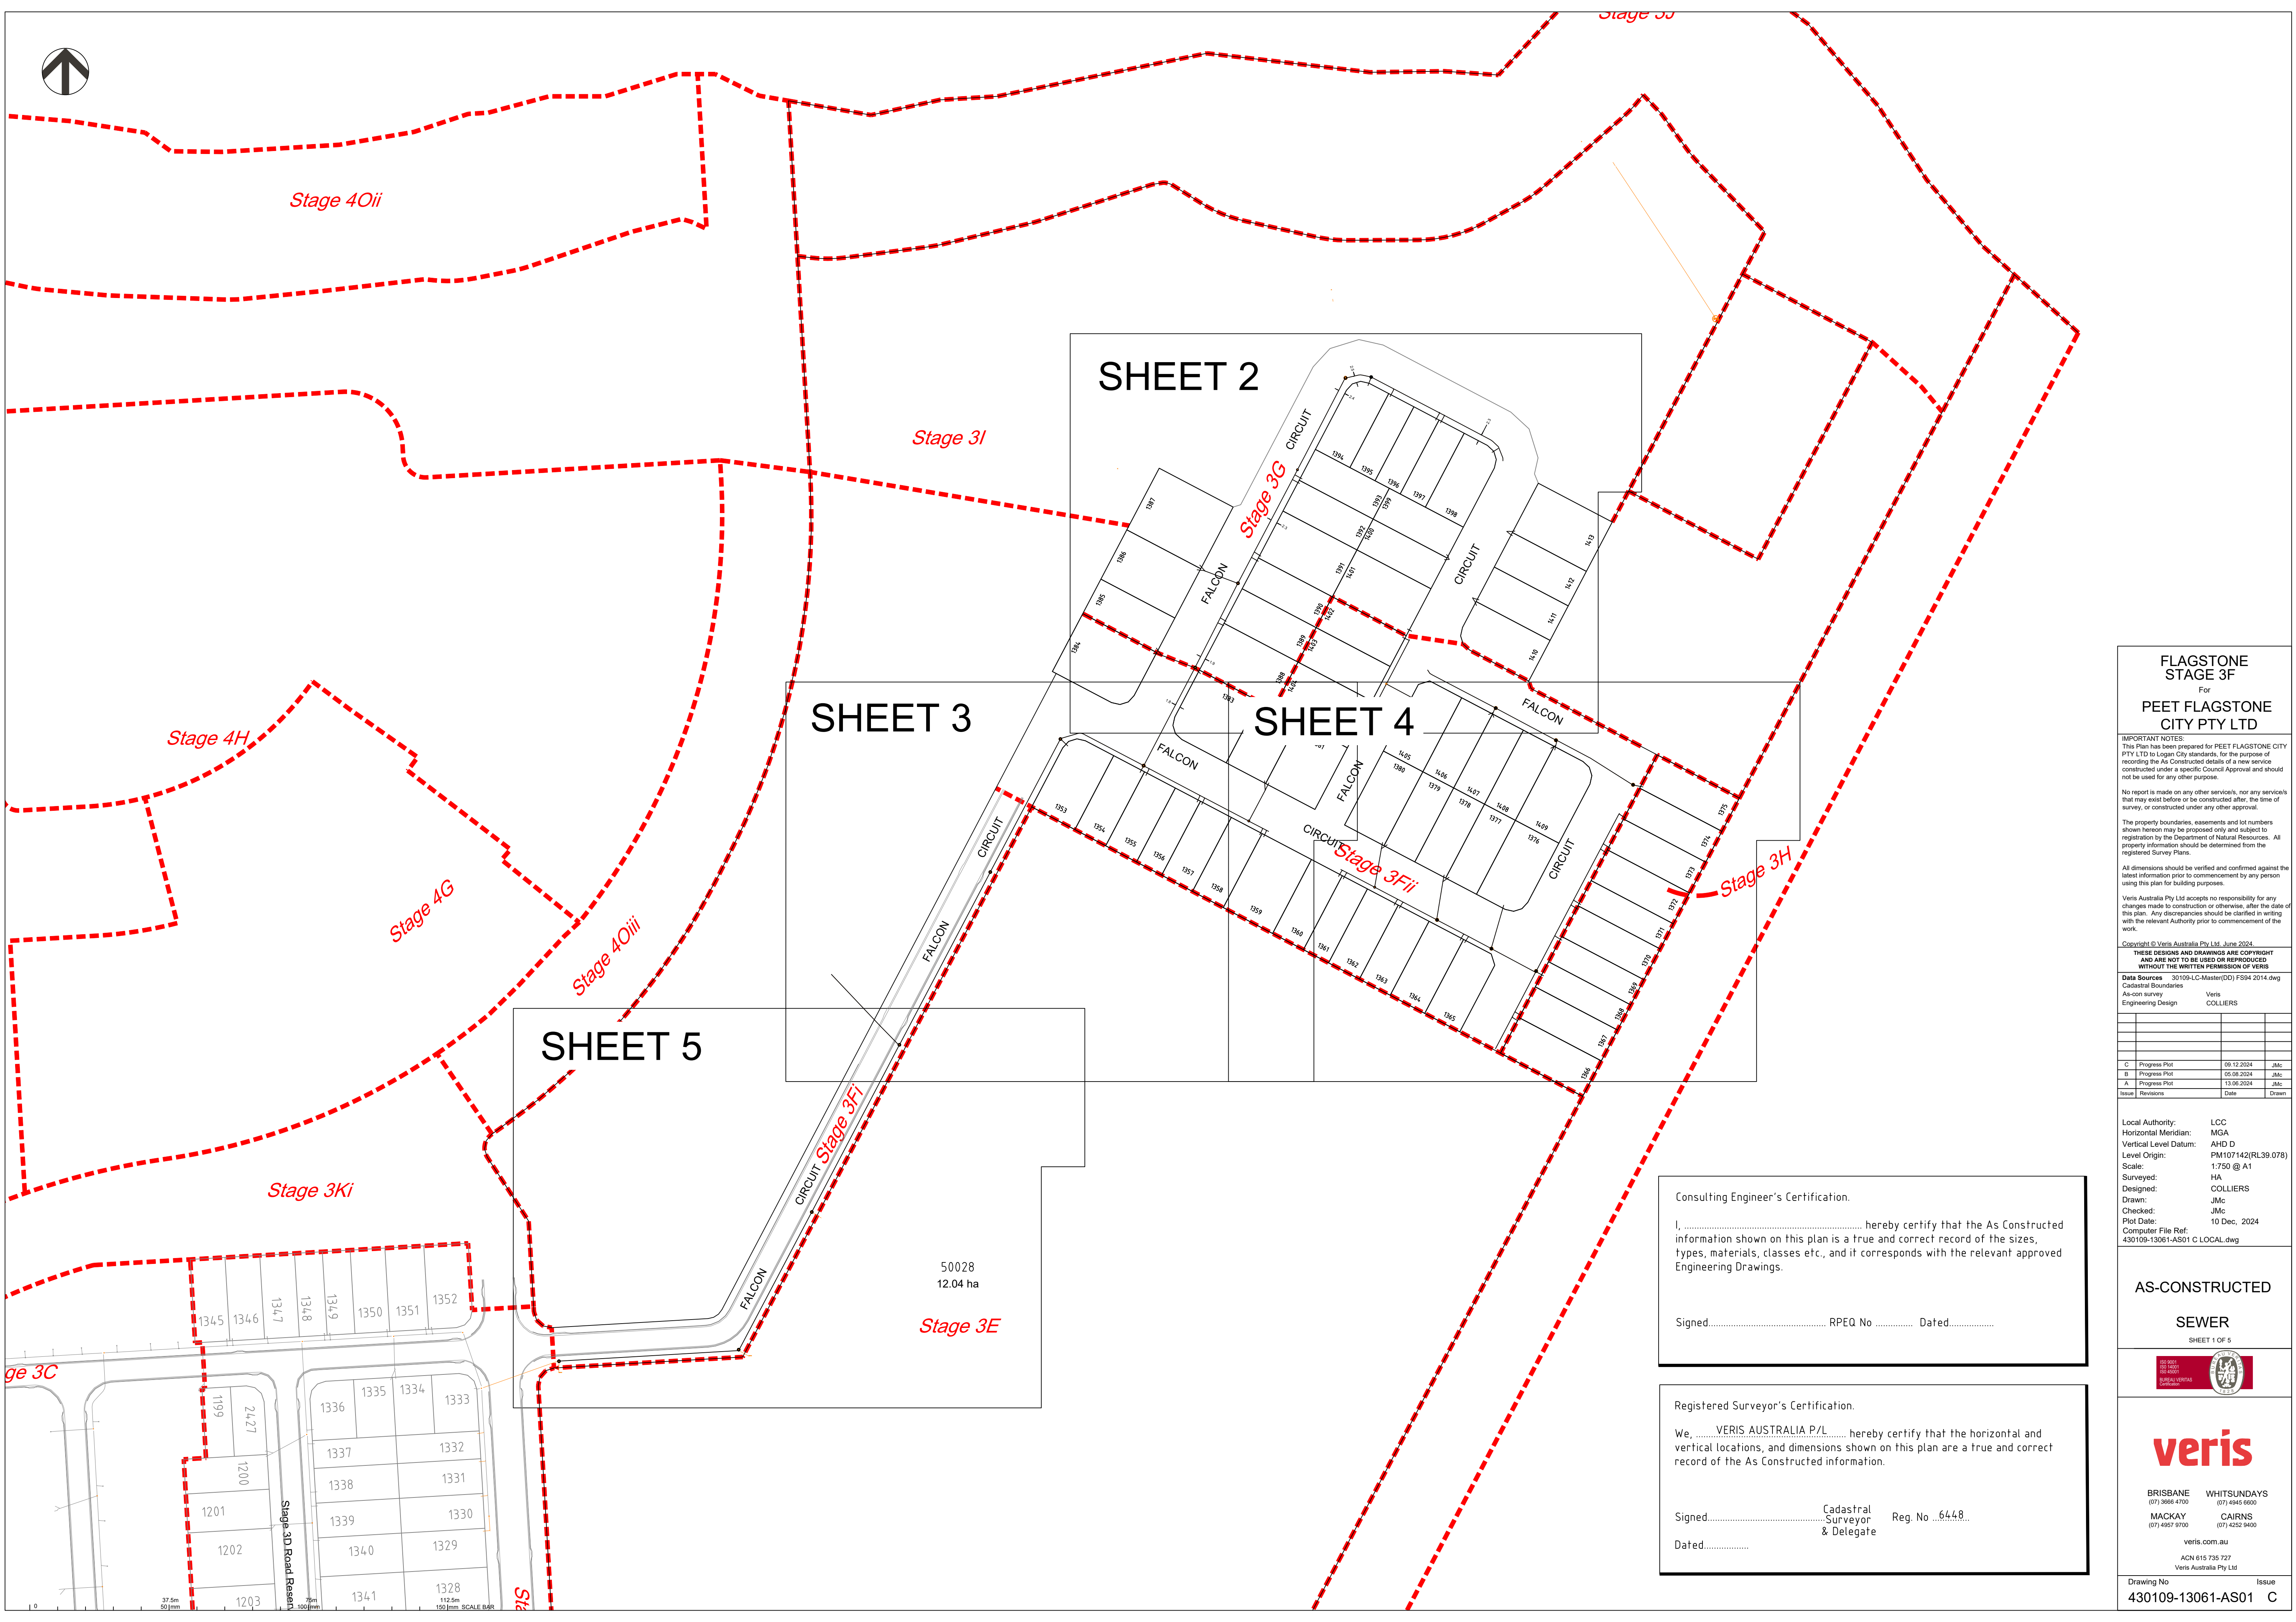

For _____

has been prepared for PEET FLAGSTONE CITY
Logan City standards, for the purpose of
As Constructed details of a new service
under a specific Council Approval and should
for any other purpose.

is made on any other service/s, nor any service/s
exist before or be constructed after, the time of
constructed under any other approval.

ty boundaries, easements and lot numbers
can may be proposed only and subject to
by the Department of Natural Resources. All
formation should be determined from the
Survey Plans.

Plans should be verified and confirmed against the information prior to commencement by any person responsible for building purposes.

© Veris Australia Pty Ltd, June 2021

DESIGNS AND DRAWINGS ARE COPYRIGHT
ARE NOT TO BE USED OR REPRODUCED
OUT THE WRITTEN PERMISSION OF VERIS

ces 30109-LC-Master(DD) FS94 2014.dwg

Veris
COLLIERS

Less Plot	09.12.2024	JMc
Less Plot	05.08.2024	JMc
Less Plot	13.06.2024	JMc
ions	Date	Drawn

Authority: LCC
 National Meridian: MGA
 Level Datum: AHD D
 Origin: PM107142(RL39.078)
 1:750 @ A1
 Scale: HA
 Project: COLLIERS
 Drawing: JMc
 Drawing: JMc
 Date: 10 Dec, 2024
 Project File Ref: 3061-AS01 C LOCAL.dwg

SEWER

SHEET 1 OF 5



RISBANE WHITSUND

(07) 3666 4700 (07) 4945 66

MACKAY	CAIRNS
(07) 4057 0700	(07) 4050 0

774531 3100 (01) 4202 5-

veris.com.au

ACN 615 735 727

Veris Australia Pty Ltd

g No

109-13061-AS0



Consulting Engineer's Certification.

I, hereby certify that the As Constructed information shown on this plan is a true and correct record of the sizes, types, materials, classes etc., and it corresponds with the relevant approved Engineering Drawings.


Signed..... RPEQ No Dated.....

Registered Surveyor's Certification.

We, VERIS AUSTRALIA P/L hereby certify that the horizontal and vertical locations, and dimensions shown on this plan are a true and correct record of the As Constructed information.

Signed..... Cadastral Surveyor Reg. No 6448

Dated.....

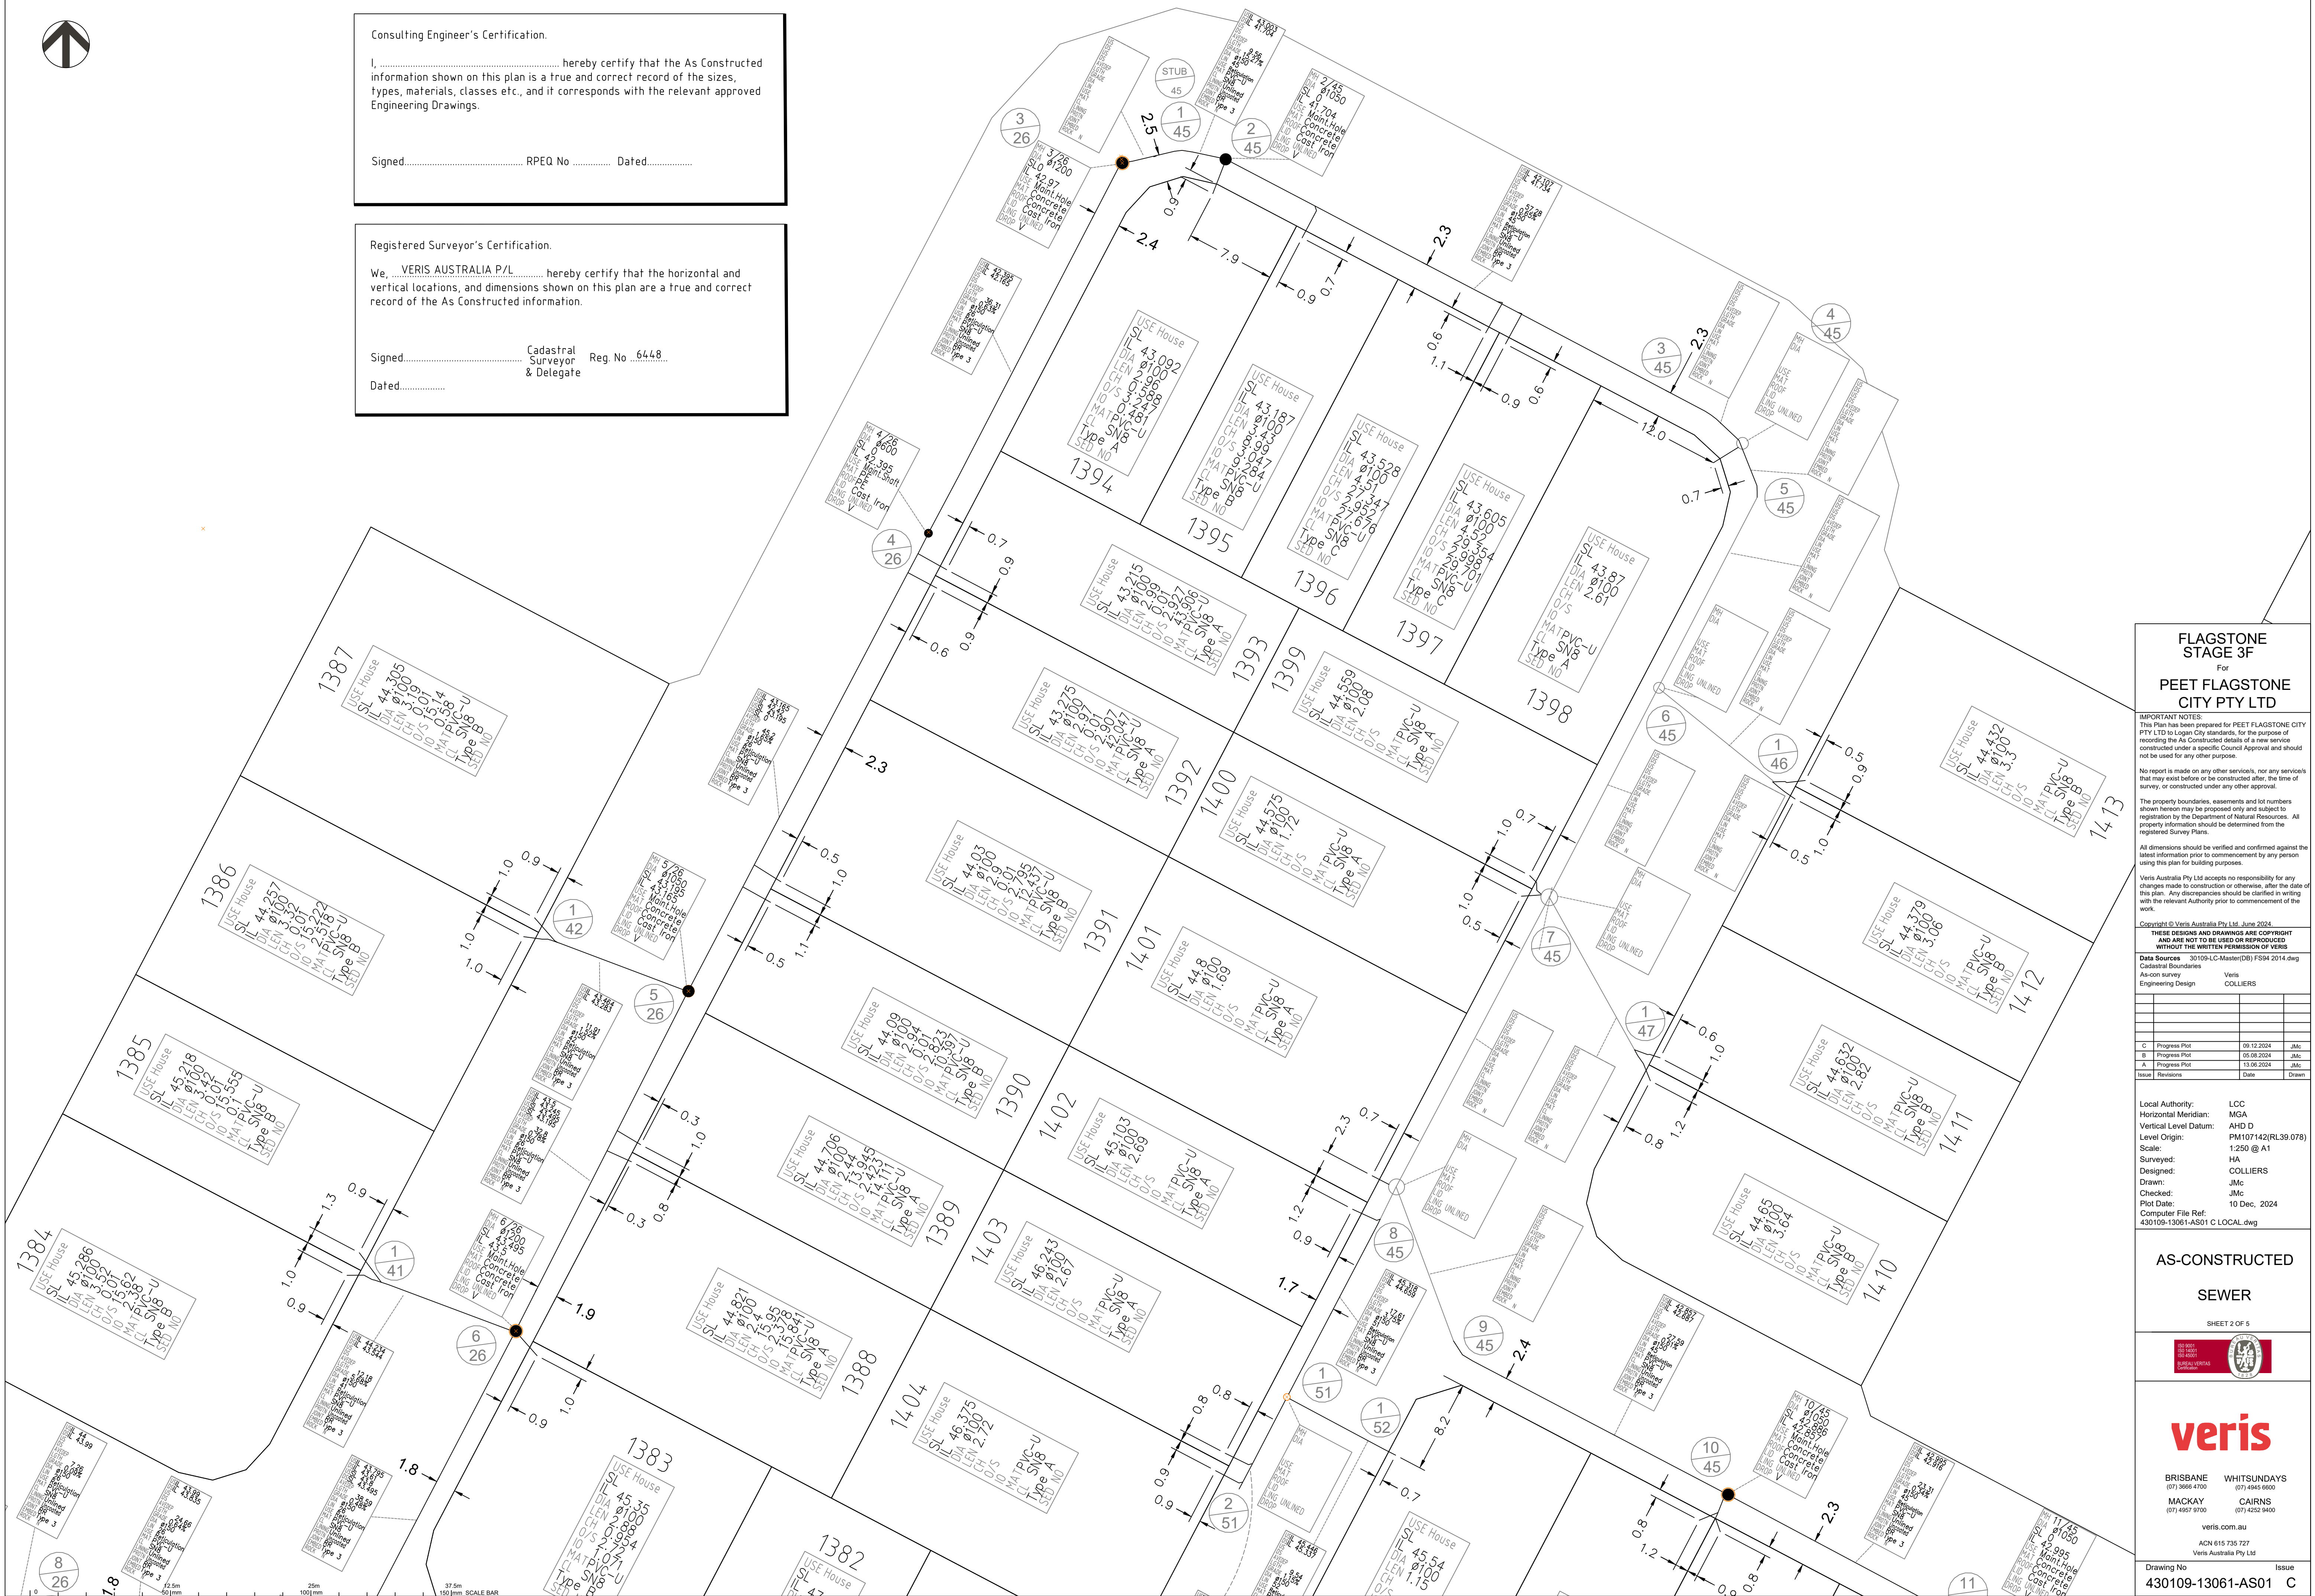

FLAGSTONE
STAGE 3F
For
PEET FLAGSTONE
CITY PTY LTD

IMPORTANT NOTES:
This Plan has been prepared for PEET FLAGSTONE CITY PTY LTD to Logan City standards, for the purpose of recording the As Constructed details of a new service constructed under a specific Council Approval and should not be used for any other purpose.

No report is made on any other service/s, nor any service/s that may exist before or be constructed after, the time of survey, or constructed under any other approval.

The property boundaries, easements and lot numbers shown hereon may be proposed only and subject to registration by the Department of Natural Resources. All property information should be determined from the registered Survey Plans.

All dimensions should be verified and confirmed against the latest information prior to commencement by any person using this plan for building purposes.

Veris Australia Pty Ltd accepts no responsibility for any changes made to construction or otherwise, after the date of this plan. Any discrepancies should be clarified in writing with the relevant Authority prior to commencement of the work.

Copyright © Veris Australia Pty Ltd. June 2024.

THESE DESIGNS AND DRAWINGS ARE COPYRIGHT AND ARE NOT TO BE USED OR REPRODUCED WITHOUT THE WRITTEN PERMISSION OF VERIS

Data Sources 30109-LC-Master(DB) F594 2014.dwg

Cadastral Boundaries

As-con survey

Engineering Design

Veris

COLLIERS

Local Authority: LCC

Horizontal Meridian: MGA

Vertical Level Datum: AHD D

Level Origin: PM107142(RL39.078)

Scale: 1:250 @ A1

Surveyed: HA

Designed: COLLIERS

Drawn: JMc

Checked: JMc

Plot Date: 10 Dec, 2024

Computer File Ref: 430109-13061-AS01 C LOCAL.dwg

AS-CONSTRUCTED

SEWER

SHEET 2 OF 5



BRISBANE WHITSUNDAYS
(07) 3666 4700 (07) 4945 6600
MACKAY CAIRNS
(07) 4951 9100 (07) 4222 9400

veris.com.au


ACN 615 735 727

Veris Australia Pty Ltd

Drawing No

Issue

430109-13061-AS01 C

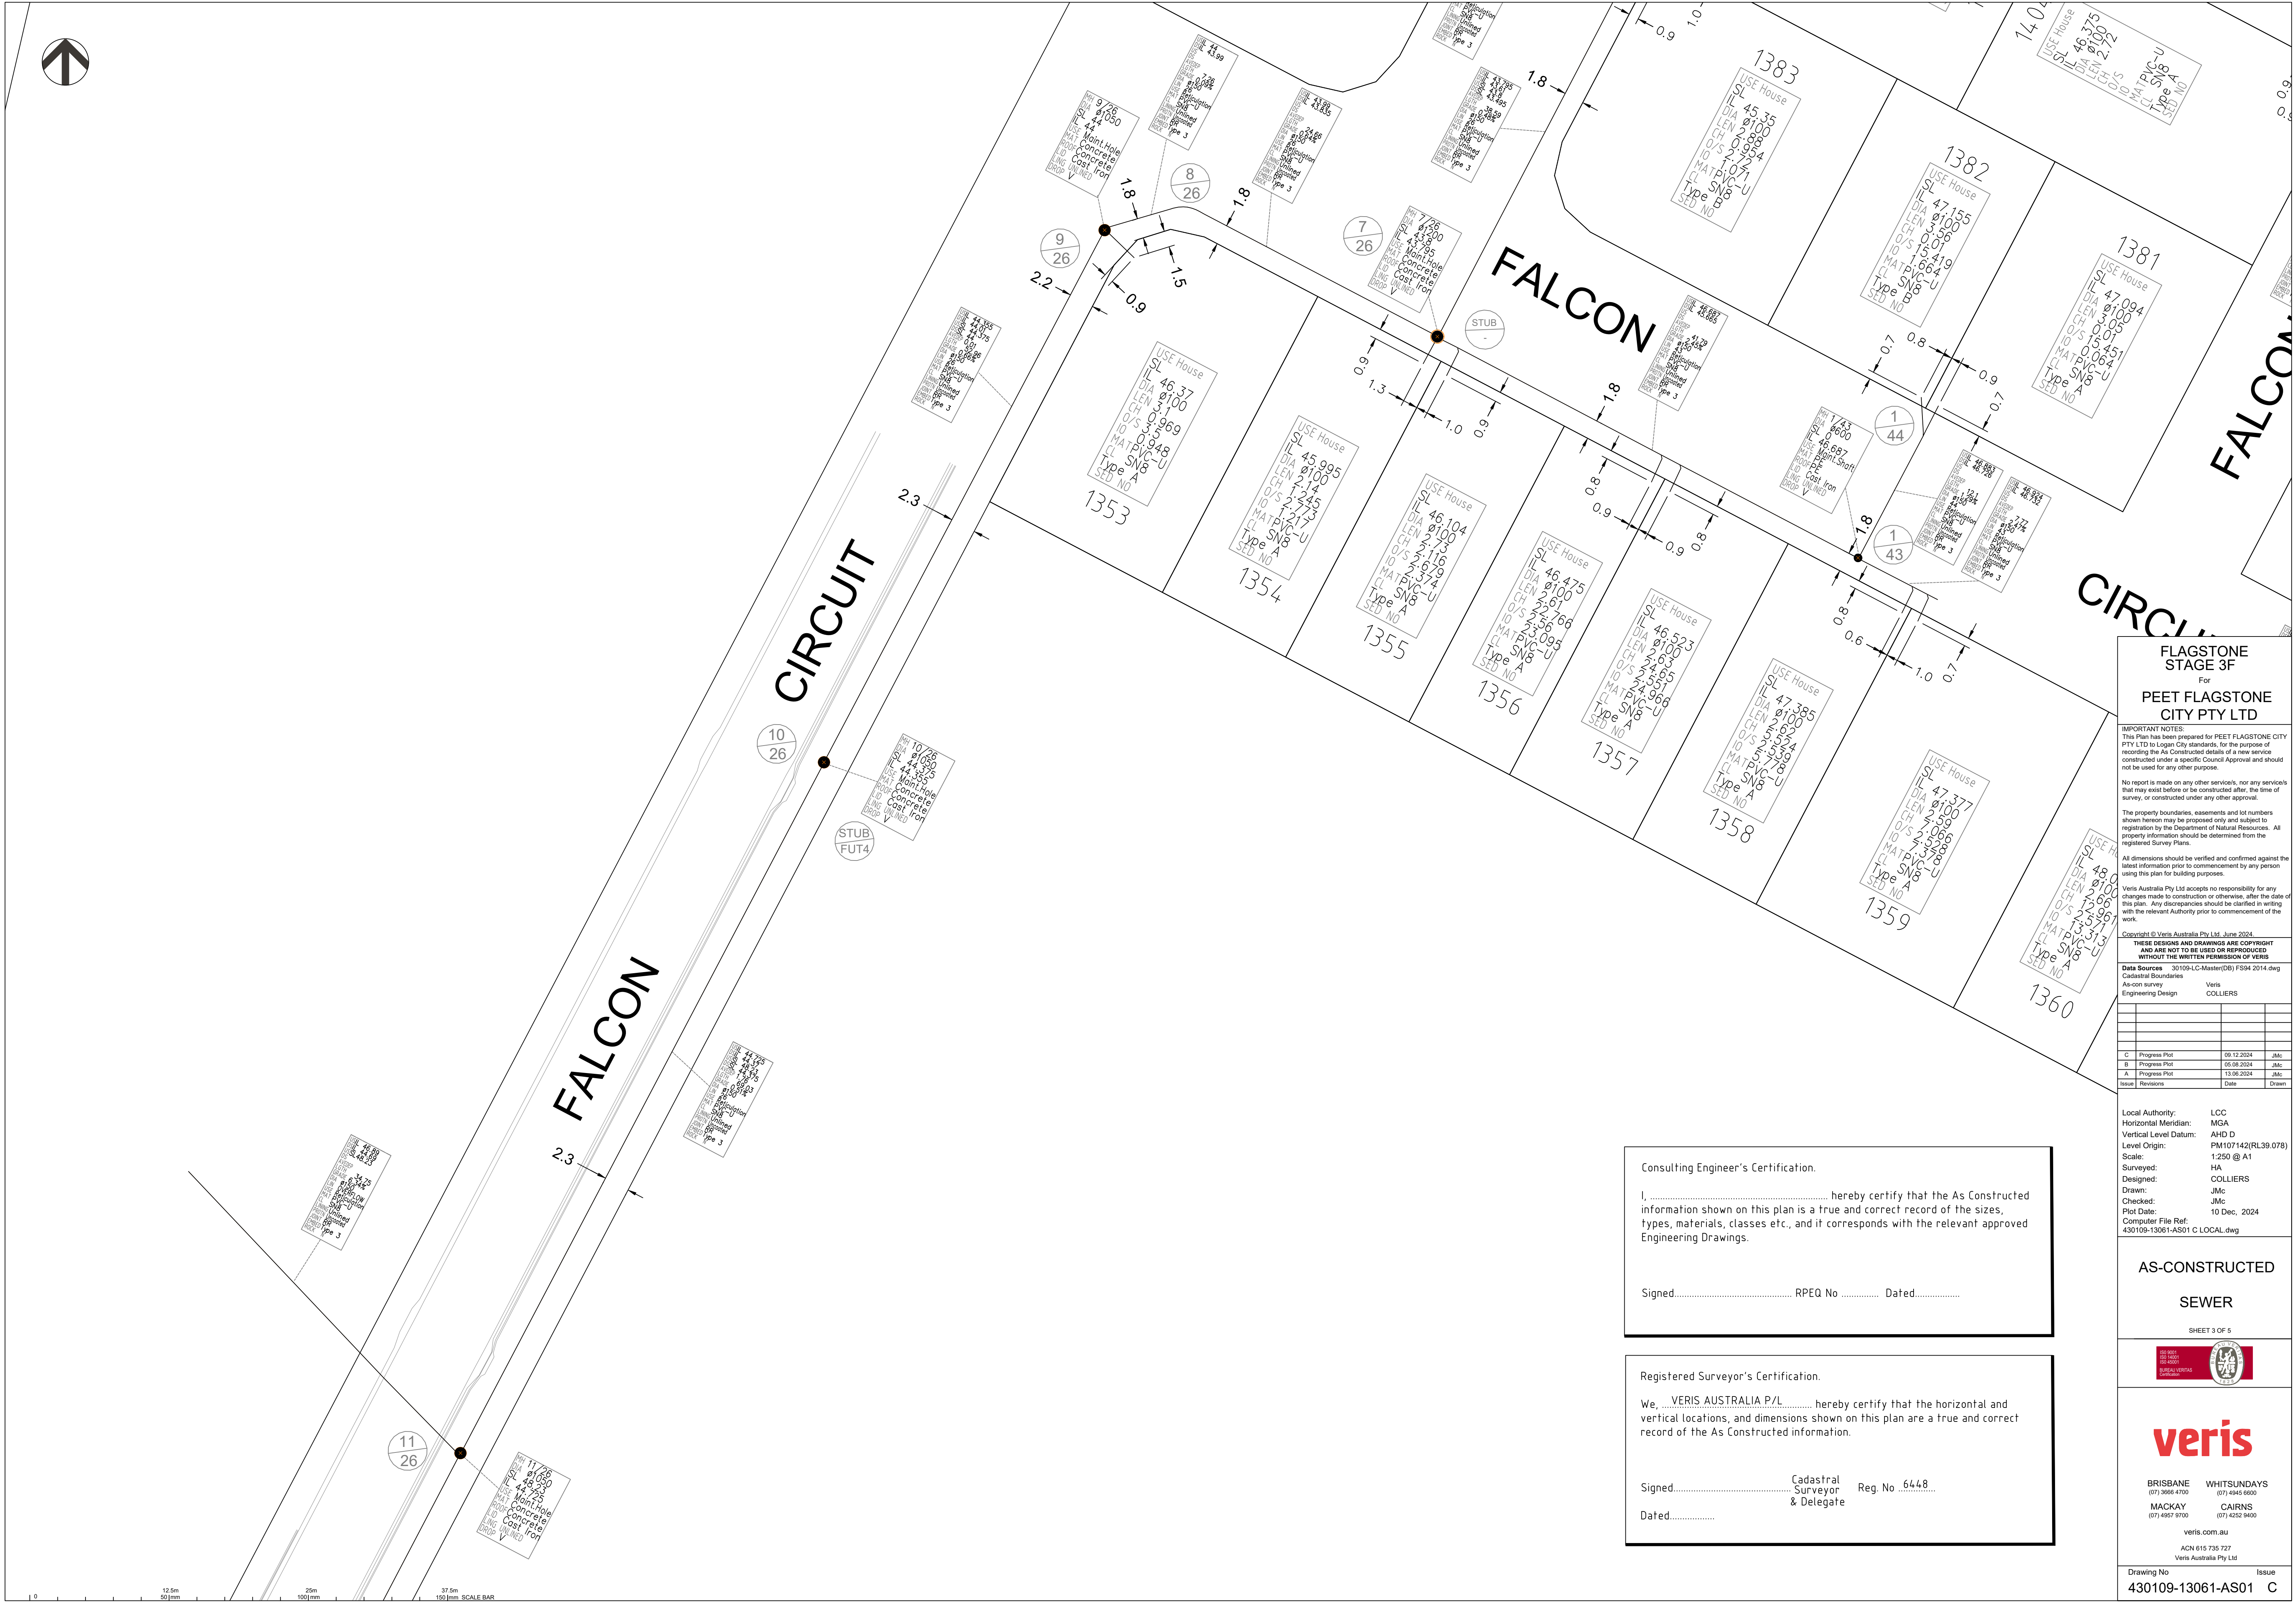

FLAGSTONE
STAGE 3F
For
PEET FLAGSTONE
CITY PTY LTD

IMPORTANT NOTES:
This Plan has been prepared for PEET FLAGSTONE CITY PTY LTD to Logan City standards, for the purpose of recording the As Constructed details of a new service constructed under a specific Council Approval and should not be used for any other purpose.

No report is made on any other service's, nor any services that may exist before or be constructed after, the time of survey, or constructed under any other approval.

The property boundaries, easements and lot numbers shown hereon may be proposed only and subject to registration by the Department of Natural Resources. All property information should be determined from the registered Survey Plans.

All dimensions should be verified and confirmed against the latest information prior to commencement by any person using this plan for building purposes.

Veris Australia Pty Ltd accepts no responsibility for any changes made to construction or otherwise, after the date of this plan. Any discrepancies should be clarified in writing with the relevant Authority prior to commencement of the work.

Copyright © Veris Australia Pty Ltd. June 2024.
THESE DESIGNS AND DRAWINGS ARE COPYRIGHT AND ARE NOT TO BE USED OR REPRODUCED WITHOUT THE WRITTEN PERMISSION OF VERIS

Data Sources 30 109-LC-Master(DB) F594 2014 dwg

Cadastral Boundaries As-con survey Veris

Engineering Design COLLIER'S

C	Progress Plot	09.12.2024	JMc
B	Progress Plot	05.08.2024	JMc
A	Progress Plot	13.06.2024	JMc
Issue	Revisions	Date	Drawn

Local Authority: LCC
Horizontal Meridian: MGA
Vertical Level Datum: AHD D
Level Origin: PM107142(RL39.078)
Scale: 1:250 @ A1
Surveyed: HA
Designed: COLLIER'S
Drawn: JMc
Checked: JMc
Plot Date: 10 Dec, 2024
Computer File Ref: 430109-13061-AS01 C LOCAL.dwg

AS-CONSTRUCTED
SEWER

SHEET 3 OF 5



veris

BRISBANE (07) 3666 4700 WHITSUNDAYS (07) 4945 6600
MACKAY (07) 4951 9100 CAIRNS (07) 4232 9400

veris.com.au
ACN 615 735 727
Veris Australia Pty Ltd

Drawing No 430109-13061-AS01 C Issue

Consulting Engineer's Certification.

I, hereby certify that the As Constructed information shown on this plan is a true and correct record of the sizes, types, materials, classes etc., and it corresponds with the relevant approved Engineering Drawings.


Signed..... RPEQ No Dated.....

Registered Surveyor's Certification.

We, VERIS AUSTRALIA P/L hereby certify that the horizontal and vertical locations, and dimensions shown on this plan are a true and correct record of the As Constructed information.

Signed..... Cadastral Surveyor Reg. No. 6448 & Delegate

Dated.....

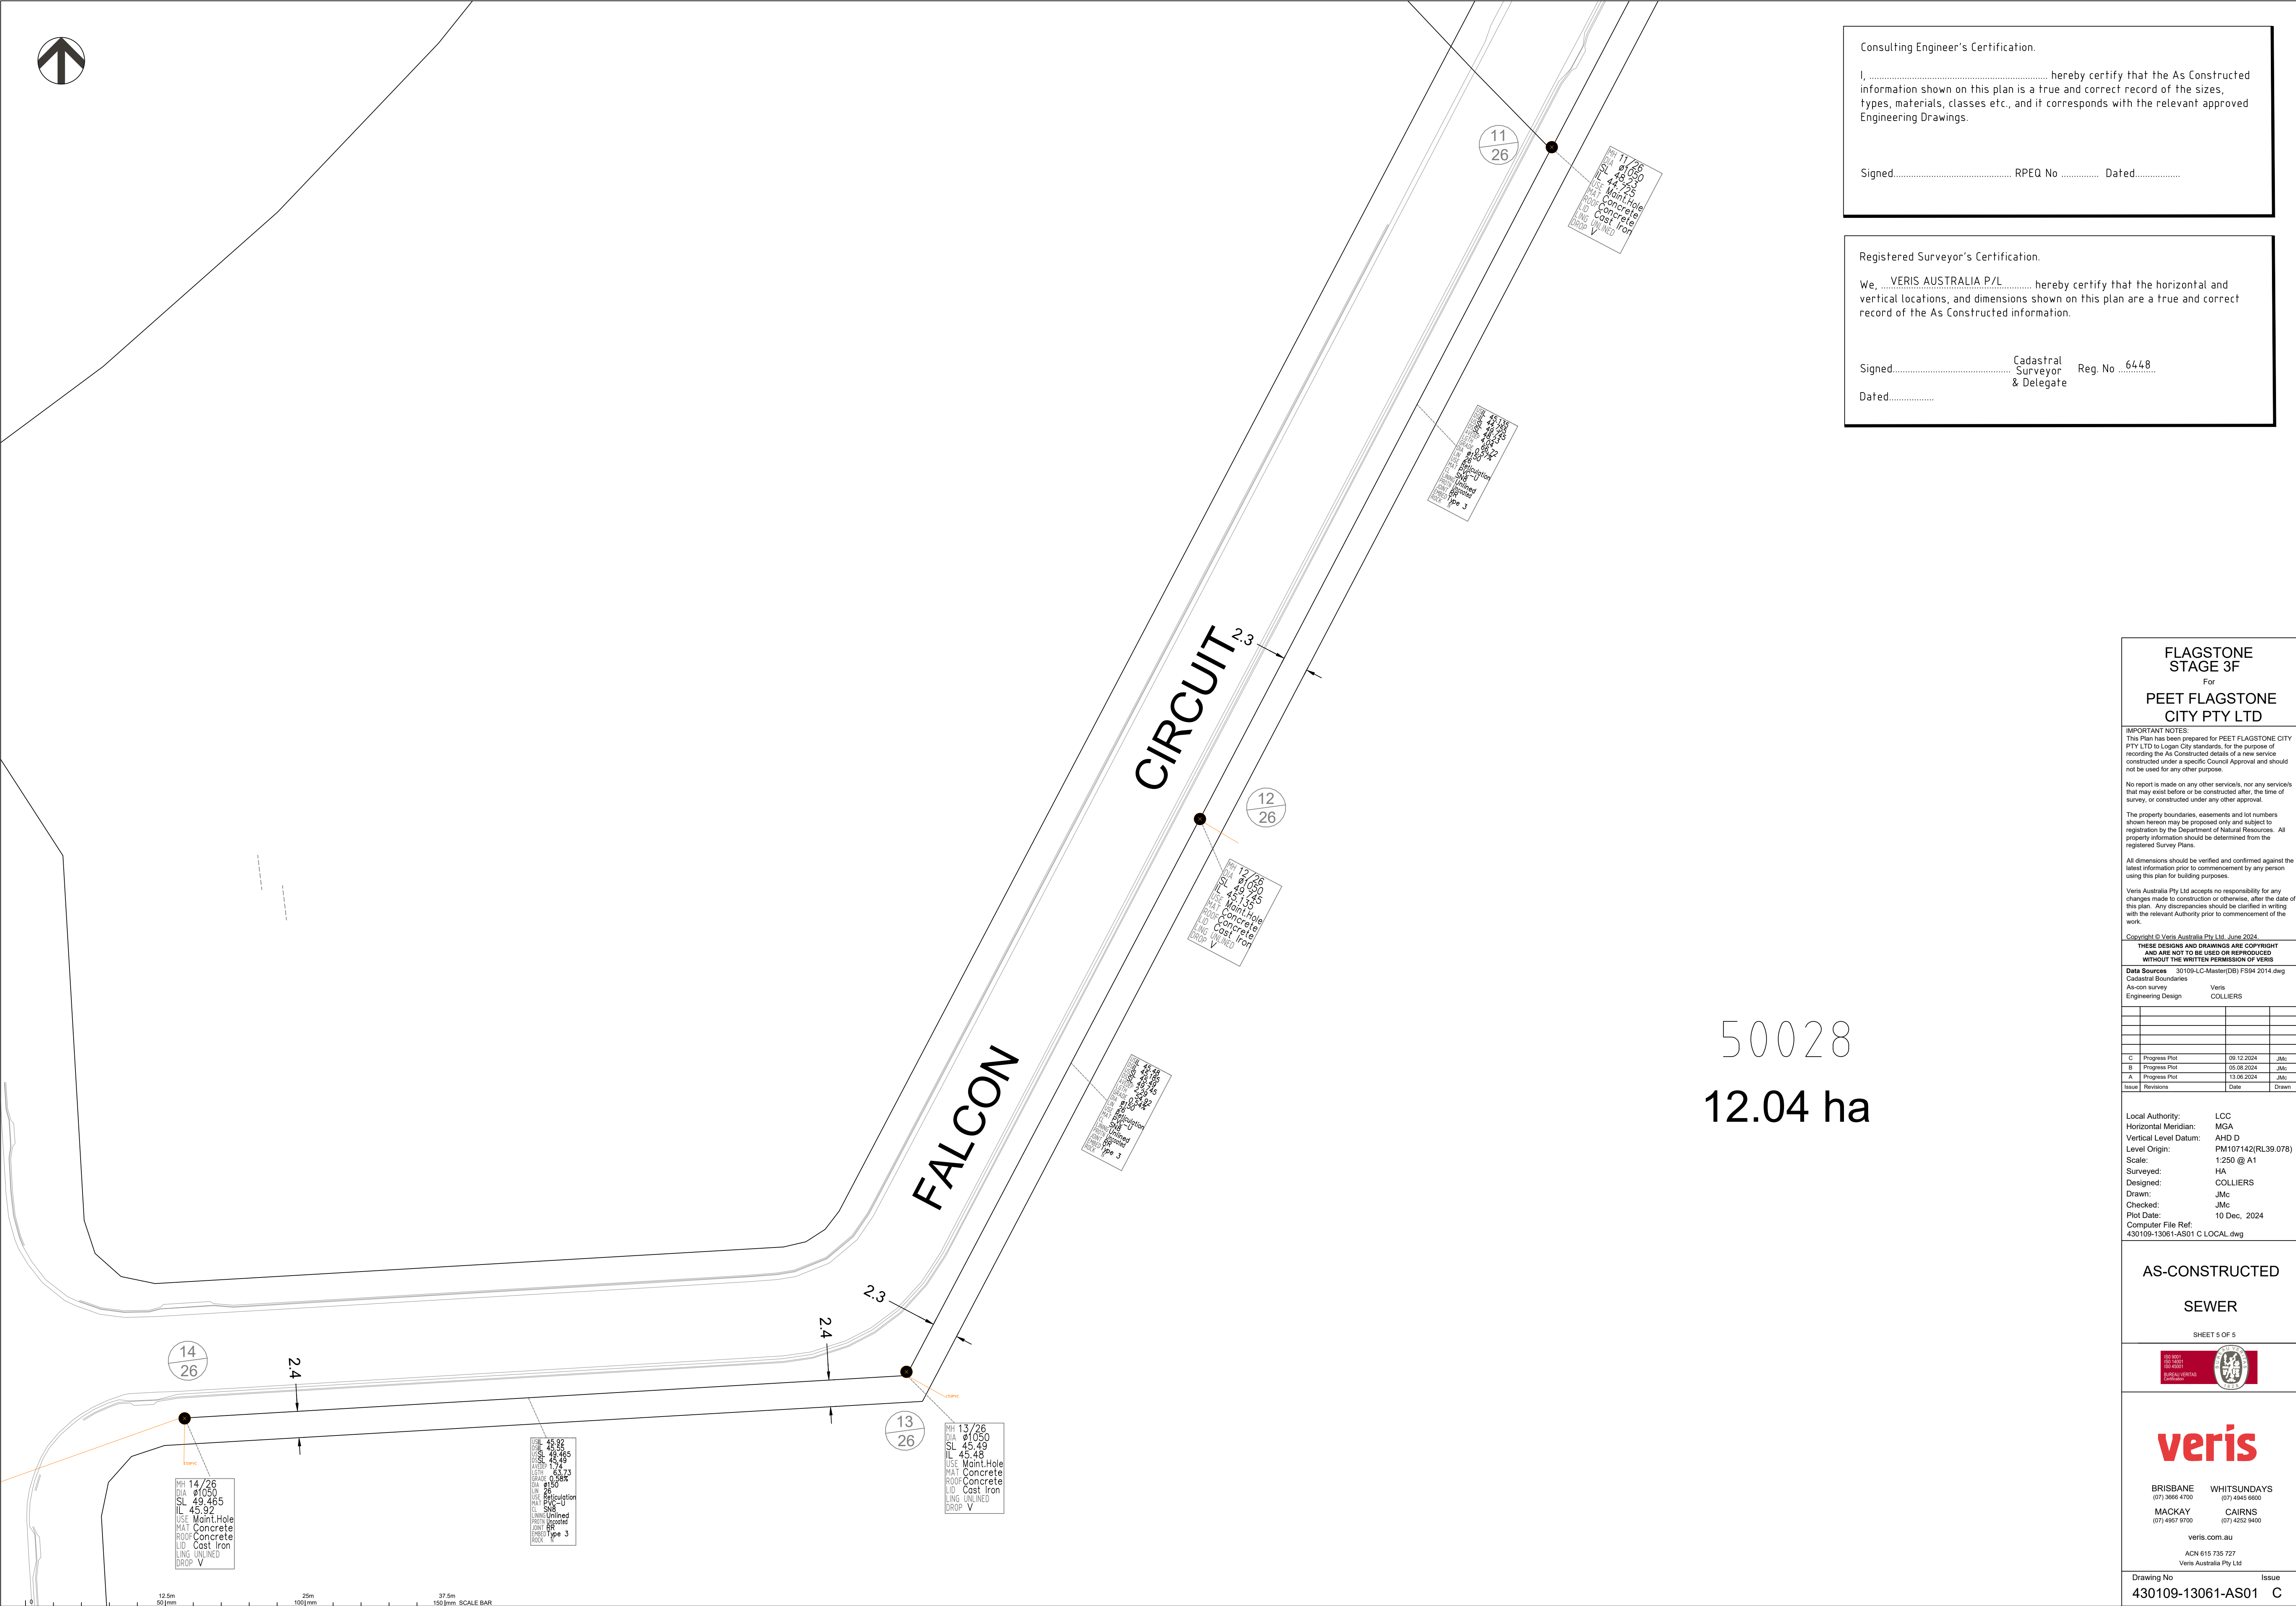

Consulting Engineer's Certification.

I, hereby certify that the As Constructed information shown on this plan is a true and correct record of the sizes, types, materials, classes etc., and it corresponds with the relevant approved Engineering Drawings.

Signed..... RPEQ No Dated.....

Registered Surveyor's Certification.

We, ...VERIS AUSTRALIA P/L..... hereby certify that the horizontal and vertical locations, and dimensions shown on this plan are a true and correct record of the As Constructed information.

Signed..... Cadastral Surveyor & Delegate Reg. No ...6448

Dated.....

FLAGSTONE
STAGE 3F
For
PEET FLAGSTONE
CITY PTY LTD

IMPORTANT NOTES:

This Plan has been prepared for PEET FLAGSTONE CITY PTY LTD to Logon City standards, for the purpose of recording the As Constructed details of a new service constructed under a specific Council Approval and should not be used for any other purpose.

No report is made on any other service's, nor any service's that may exist before or be constructed after, the time of survey, or constructed under any other approval.

The property boundaries, easements and lot numbers shown hereon may be proposed only and subject to registration by the Department of Natural Resources. All property information should be determined from the registered Survey Plans.

All dimensions should be verified and confirmed against the latest information prior to commencement by any person using this plan for building purposes.

Veris Australia Pty Ltd accepts no responsibility for any changes made to construction or otherwise, after the date of this plan. Any discrepancies should be clarified in writing with the relevant Authority prior to commencement of the work.

Copyright © Veris Australia Pty Ltd. June 2024.

THESE DESIGNS AND DRAWINGS ARE COPYRIGHT AND ARE NOT TO BE USED OR REPRODUCED WITHOUT THE WRITTEN PERMISSION OF VERIS

Data Sources 30109-LC-Master(DB) F594 2014.dwg

Cadastral Boundaries As-con survey Veris

Engineering Design COLLIER'S

C	Progress Plot	09/12/2024	JMc
B	Progress Plot	05/09/2024	JMc
A	Progress Plot	13/06/2024	JMc
Issue	Revisions	Date	Drawn

Local Authority: LCC

Horizontal Meridian: MGA

Vertical Level Datum: AHD D

Level Origin: PM107142(RL39.078)

Scale: 1:250 @ A1

Surveyed: HA

Designed: COLLIER'S

Drawn: JMc

Checked: JMc

Plot Date: 10 Dec, 2024

Computer File Ref: 430109-13061-AS01 C LOCAL.dwg

AS-CONSTRUCTED
SEWER

SHEET 5 OF 5

BRISBANE
(07) 3666 4700

WHITSUNDAYS
(07) 4945 6600

MACKAY
(07) 4951 9100

CAIRNS
(07) 4222 9400

veris.com.au

ACN 615 735 727
Veris Australia Pty Ltd

Drawing No
430109-13061-AS01

Issue
C



**FLAGSTONE
STAGE 3F**
For
**PEET FLAGSTONE
CITY PTY LTD**

IMPORTANT NOTES:
This Plan has been prepared for PEET FLAGSTONE CITY PTY LTD to Logon City standards, for the purpose of recording the As Constructed details of a new service constructed under a specific Council Approval and should not be used for any other purpose.

No report is made on any other service's, nor any service's that may exist before or be constructed after, the time of survey, or constructed under any other approval.

The property boundaries, easements and lot numbers shown hereon may be proposed only and subject to registration by the Department of Natural Resources. All property information should be determined from the registered Survey Plans.

All dimensions should be verified and confirmed against the latest information prior to commencement by any person using this plan for building purposes.

Veris Australia Pty Ltd accepts no responsibility for any changes made to construction or otherwise, after the date of this plan. Any discrepancies should be clarified in writing with the relevant Authority prior to commencement of the work.

Copyright © Veris Australia Pty Ltd. December 2024.

THESE DESIGNS AND DRAWINGS ARE COPYRIGHT AND ARE NOT TO BE USED OR REPRODUCED WITHOUT THE WRITTEN PERMISSION OF VERIS

Data Sources 30109-LC-Master(DP) F594 2014.dwg

Cadastral Boundaries As-con survey Veris
Engineering Design COLLIERS

B	Progress Plot	16/12/2024	JMc
A	Progress Plot	10/12/2024	JMc
Issue	Revisions	Date	Drawn

Local Authority: LCC
Horizontal Meridian: MGA
Vertical Level Datum: AHD D
Level Origin: PM107142(RL39.078)
Scale: 1:750 @ A1
Surveyed: HA
Designed: COLLIERS
Drawn: JMc
Checked: JMc
Plot Date: 16 Dec, 2024
Computer File Ref: 430109-13061-ASW01-B LOCAL.dwg

AS-CONSTRUCTED
STORMWATER
SHEET 1 OF 4



veris
BRISBANE (07) 3666 4700 WHITSUNDAYS (07) 4945 6600
MACKAY (07) 4957 9100 CAIRNS (07) 4232 9400
veris.com.au
ACN 615 735 727
Veris Australia Pty Ltd

Drawing No Issue
430109-13061-ASW01 B

Consulting Engineer's Certification.

I, hereby certify that the As Constructed information shown on this plan is a true and correct record of the sizes, types, materials, classes etc., and it corresponds with the relevant approved Engineering Drawings.

Signed..... RPEQ No Dated.....

Registered Surveyor's Certification.

We, VERIS AUSTRALIA P/L hereby certify that the horizontal and vertical locations, and dimensions shown on this plan are a true and correct record of the As Constructed information.

Signed..... Cadastral Surveyor & Delegate Reg. No ..6448..
Dated.....



I, hereby certify that the As Constructed information shown on this plan is a true and correct record of the sizes, types, materials, classes etc., and it corresponds with the relevant approved Engineering Drawings.

Registered Surveyor's Certification.

Signed..... Cadastral Surveyor Reg. No. 6448
& Delegate
Dated.....

IMPORTANT NOTES:
This Plan has been prepared for PEET FLAGSTONE PTY LTD to Logan City standards, for the purpose of recording the As Constructed details of a new service constructed under a specific Council Approval and should not be used for any other purpose.

No report is made on any other service/s, nor any service that may exist before or be constructed after, the time of the survey, or constructed under any other approval.

The property boundaries, easements and lot numbers shown hereon may be proposed only and subject to registration by the Department of Natural Resources. property information should be determined from the registered Survey Plans.

All dimensions should be verified and confirmed against latest information prior to commencement by any person using this plan for building purposes.

Veris Australia Pty Ltd accepts no responsibility for any changes made to construction or otherwise, after the release of this plan. Any discrepancies should be clarified in writing with the relevant Authority prior to commencement of work.

Copyright © Veris Australia Pty Ltd. December 2024.

Data Sources	30109-LC-Master(DF) FS94 2014.d
Cadastral Boundaries	
As-con survey	Veris
Engineering Design	COLLIERS


Local Authority: LCC
Horizontal Meridian: MGA
Vertical Level Datum: AHD D
Level Origin: PM107142(RL39.
Scale: 1:250 @ A1
Surveyed: HA
Designed: COLLIERS
Drawn: JMc
Checked: JMc
Plot Date: 16 Dec, 2024
Computer File Ref:
430109-13061-ASW01-B LOCAL.dwg

SHEET 2 OF 4



veris.com.au
ACN 615 735 727
Veris Australia Pty Ltd

Drawing No	Issue
430109-13061-ASW01	

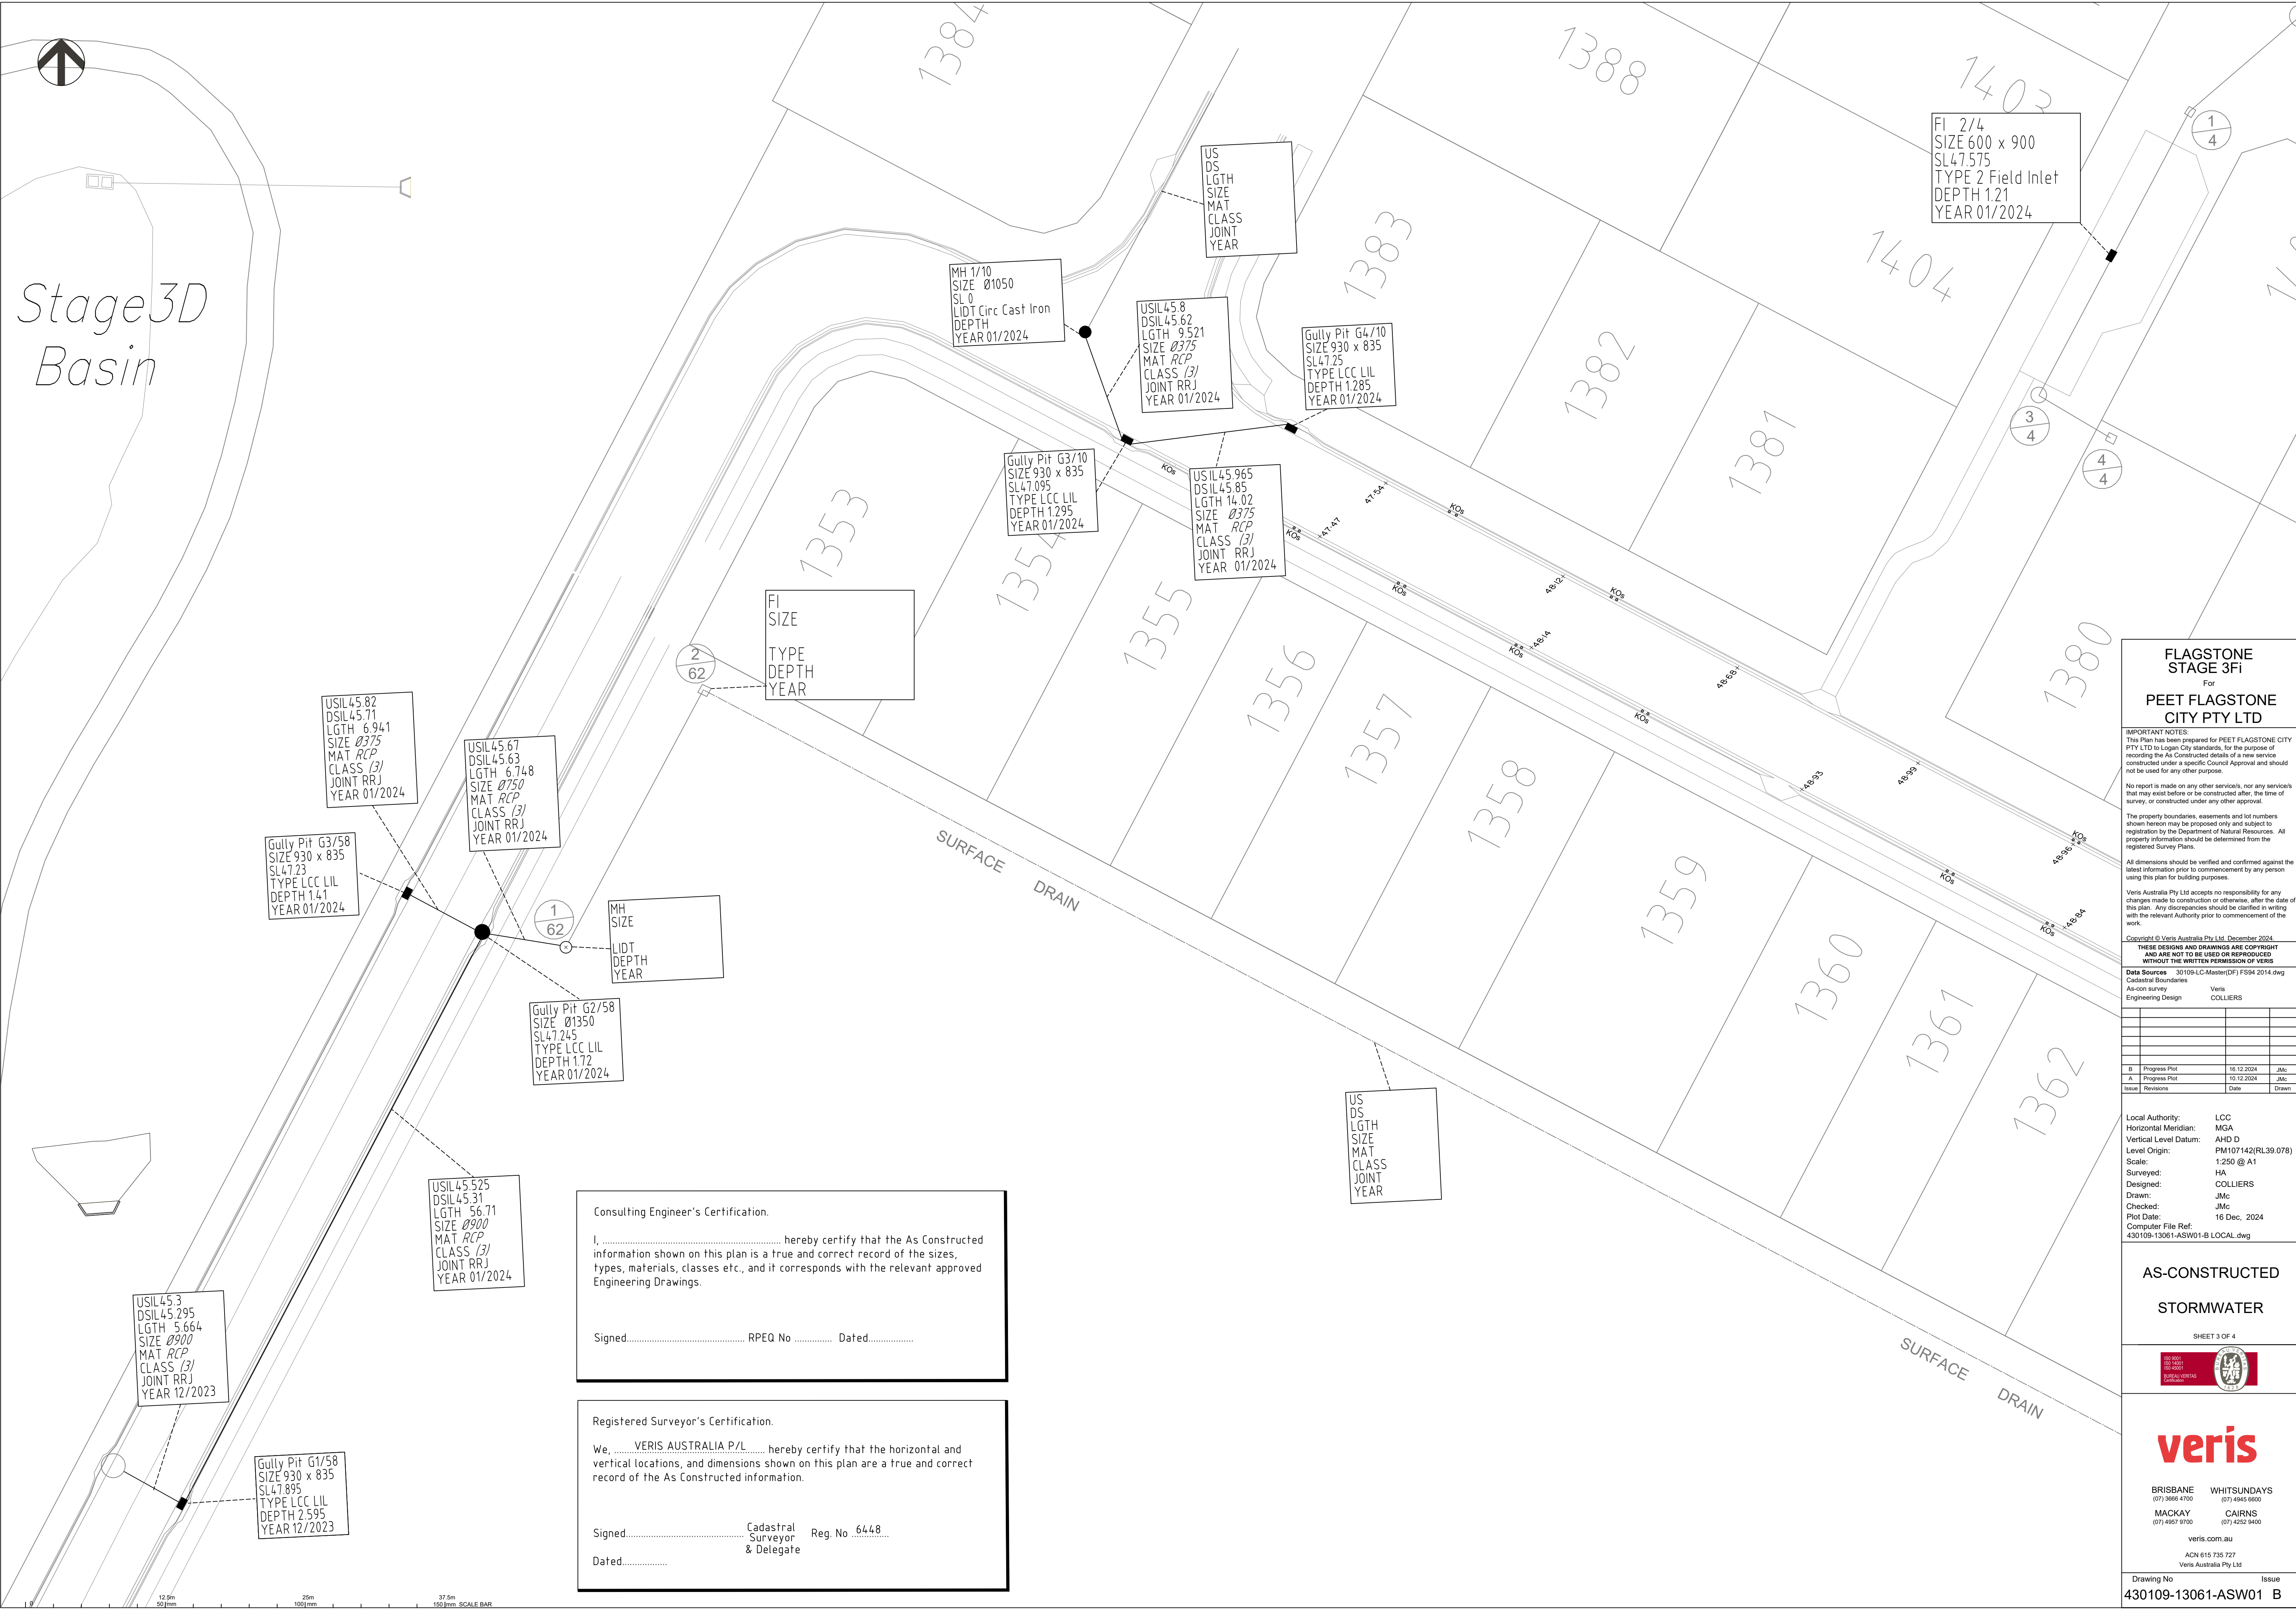

FLAGSTONE
STAGE 3FI
For
PEET FLAGSTONE
CITY PTY LTD

IMPORTANT NOTES:

This Plan has been prepared for PEET FLAGSTONE CITY PTY LTD to Logan City standards, for the purpose of recording the As Constructed details of a new service constructed under a specific Council Approval and should not be used for any other purpose.

No report is made on any other service's, nor any services that may exist before or be constructed after, the time of survey, or constructed under any other approval.

The property boundaries, easements and lot numbers shown hereon may be proposed only and subject to registration by the Department of Natural Resources. All property information should be determined from the registered Survey Plans.

All dimensions should be verified and confirmed against the latest information prior to commencement by any person using this plan for building purposes.

Veris Australia Pty Ltd accepts no responsibility for any changes made to construction or otherwise, after the date of this plan. Any discrepancies should be clarified in writing with the relevant Authority prior to commencement of the work.

Copyright © Veris Australia Pty Ltd. December 2024.

THESE DESIGNS AND DRAWINGS ARE COPYRIGHT AND ARE NOT TO BE USED OR REPRODUCED WITHOUT THE WRITTEN PERMISSION OF VERIS

Data Sources	30 109-LC-Master(DP) F594 2014.dwg
Cadastral Boundaries	
As-con survey	Veris
Engineering Design	COLLIERS

B	Progress Plot	16 12 2024	JMc
A	Progress Plot	10 12 2024	JMc
Issue	Revisions	Date	Drawn

Local Authority:	LCC
Horizontal Meridian:	MGA
Vertical Level Datum:	AHD D
Level Origin:	PM107142(RL39.078)
Scale:	1:250 @ A1
Surveyed:	HA
Designed:	COLLIERS
Drawn:	JMc
Checked:	JMc
Plot Date:	16 Dec, 2024
Computer File Ref:	430109-13061-ASW01-B LOCAL.dwg

AS-CONSTRUCTED
STORMWATER


SHEET 3 OF 4

BRISBANE (07) 3686 4700	WHITSUNDAYS (07) 4945 6600
MACKAY (07) 4951 9100	CAIRNS (07) 4232 9400

veris.com.au

ACN 615 735 727
Veris Australia Pty Ltd

Drawing No	Issue
430109-13061-ASW01	B

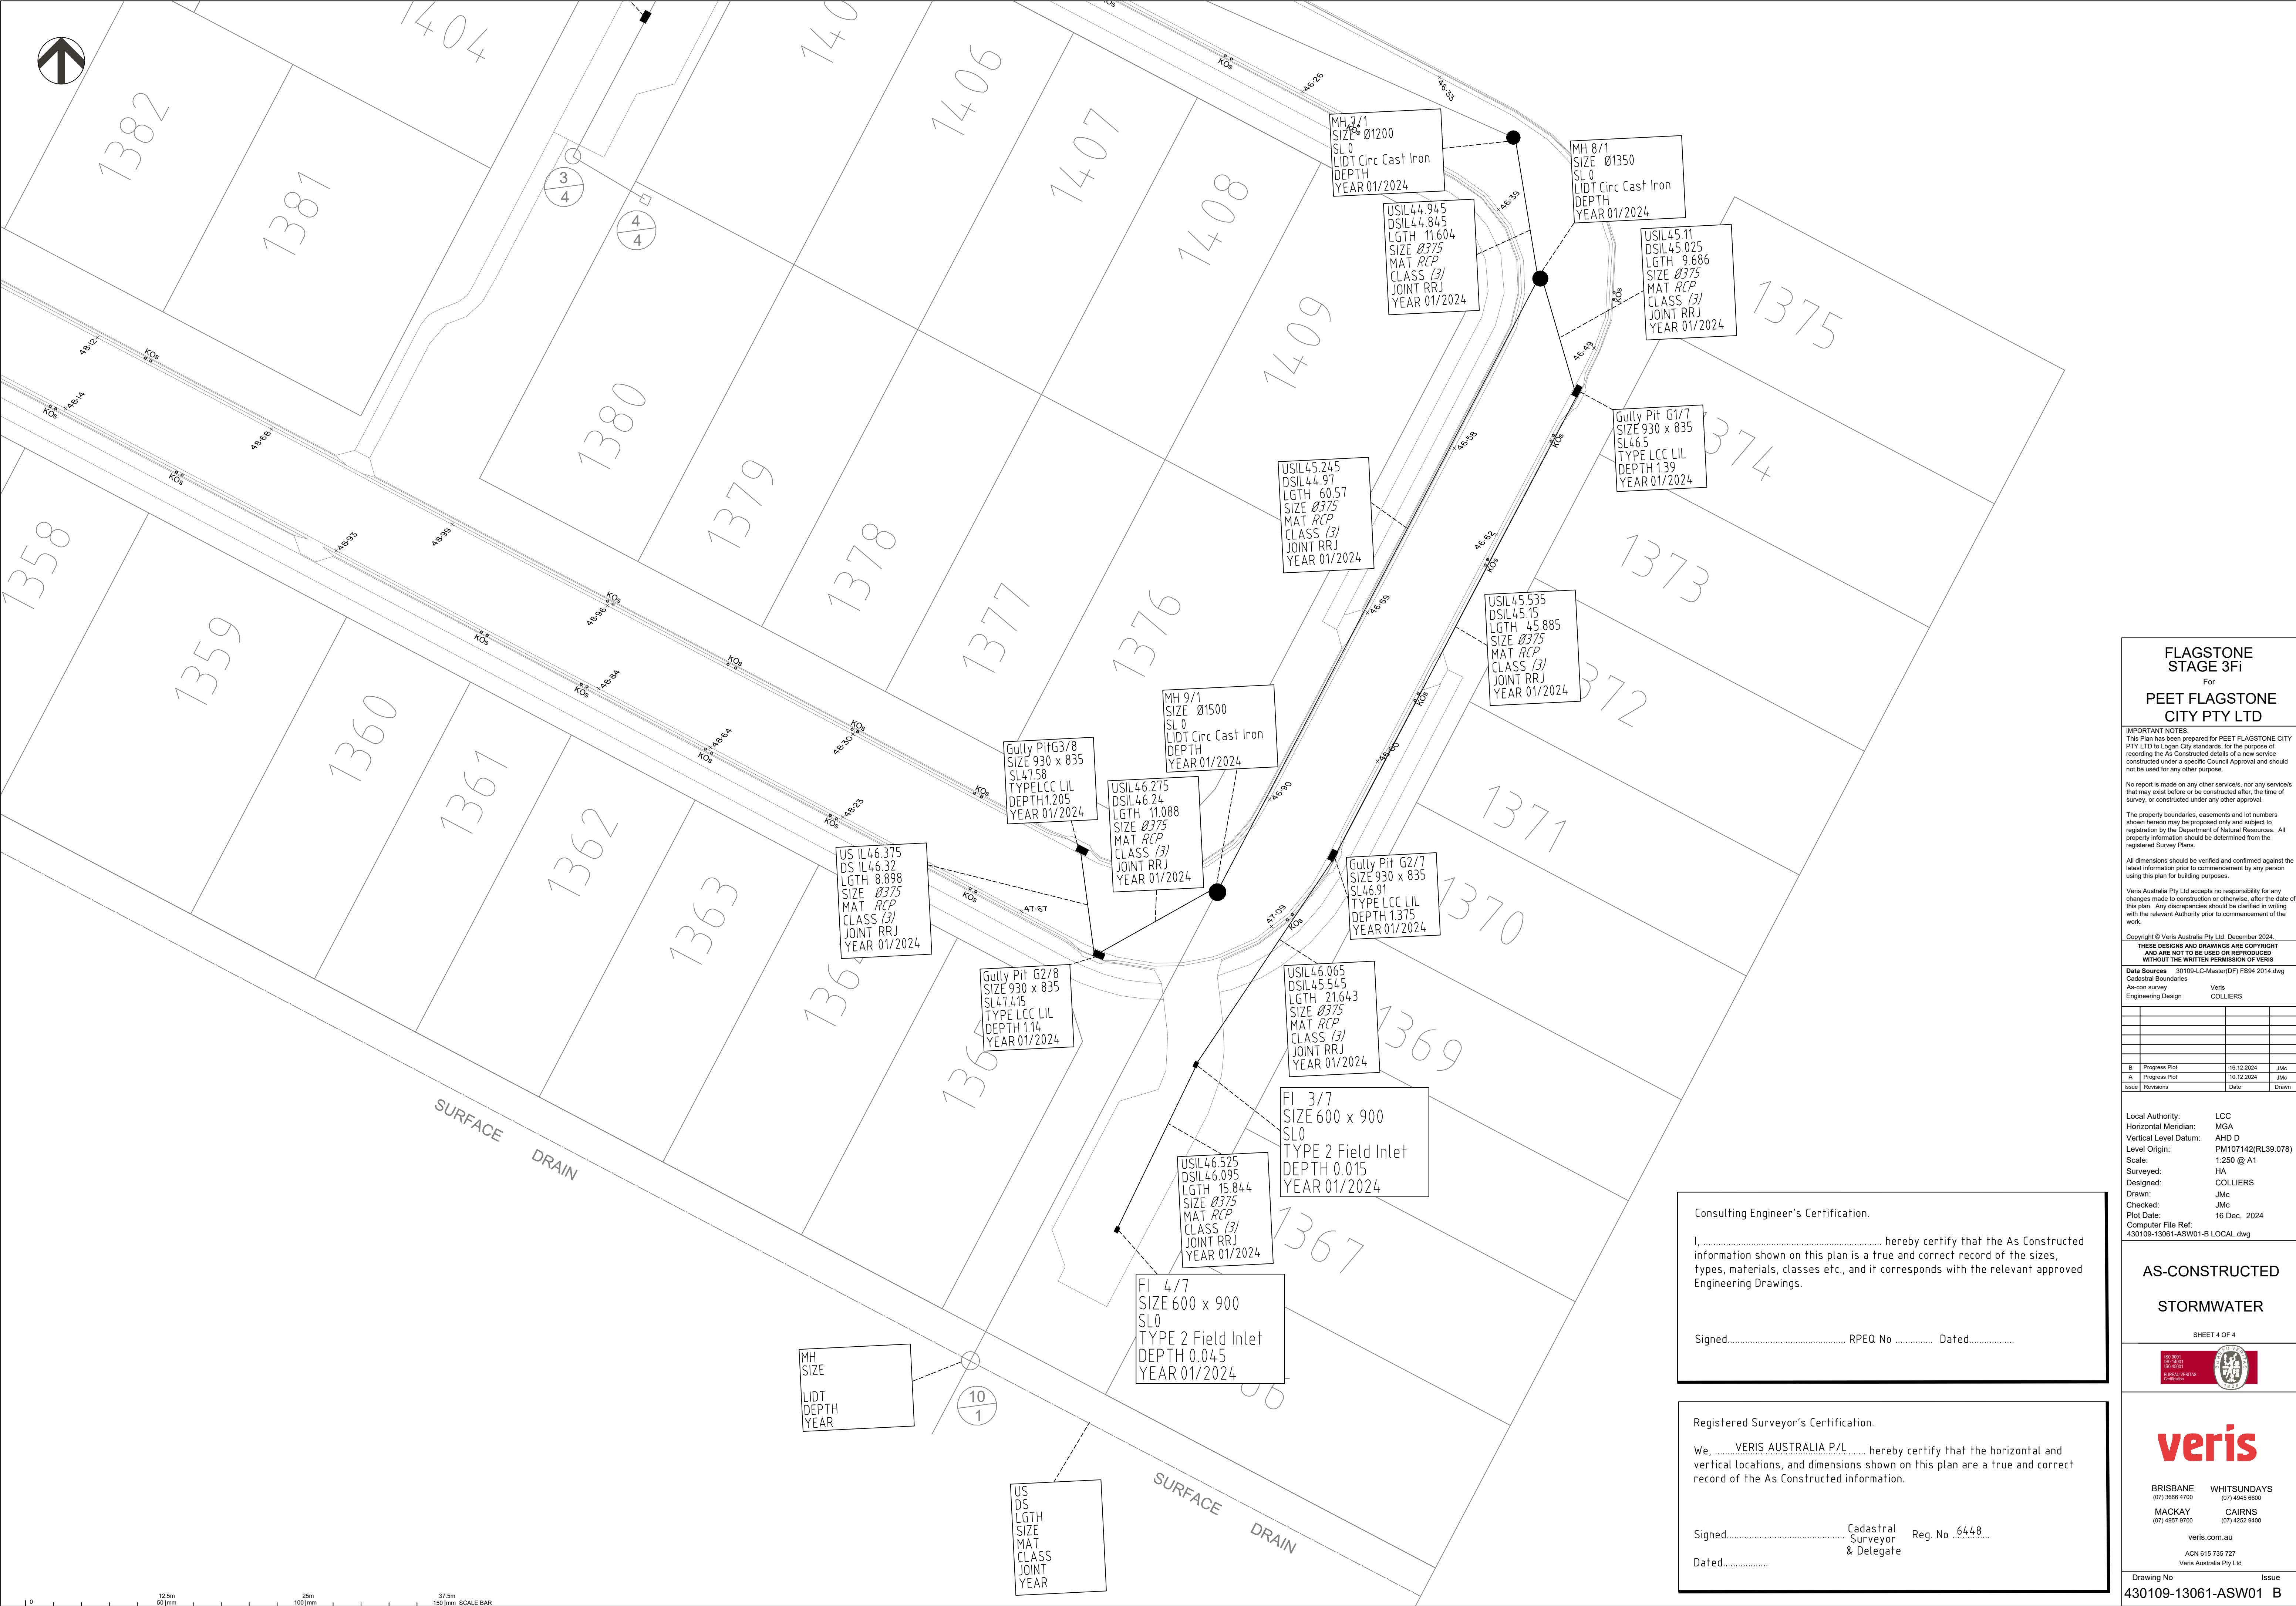

FLAGSTONE
STAGE 3FI
For
PEET FLAGSTONE
CITY PTY LTD

IMPORTANT NOTES:
This Plan has been prepared for PEET FLAGSTONE CITY PTY LTD to Logon City standards, for the purpose of recording the As Constructed details of a new service constructed under a specific Council Approval and should not be used for any other purpose.

No report is made on any other service's, nor any services that may exist before or be constructed after, the time of survey, or constructed under any other approval.

The property boundaries, easements and lot numbers shown hereon may be proposed only and subject to registration by the Department of Natural Resources. All property information should be determined from the registered Survey Plans.

All dimensions should be verified and confirmed against the latest information prior to commencement by any person using this plan for building purposes.
Veris Australia Pty Ltd accepts no responsibility for any changes made to construction or otherwise, after the date of this plan. Any discrepancies should be clarified in writing with the relevant Authority prior to commencement of the work.

Copyright © Veris Australia Pty Ltd. December 2024.

THESE DESIGNS AND DRAWINGS ARE COPYRIGHT AND ARE NOT TO BE USED OR REPRODUCED WITHOUT THE WRITTEN PERMISSION OF VERIS


Data Sources 30109-LC-Master(DP) F894 2014.dwg

Cadastral Boundaries As-con survey Veris Engineering Design COLLIER'S

B	Progress Plot	16/12/2024	JMc
A	Progress Plot	10/12/2024	JMc
Issue	Revisions	Date	Drawn

Local Authority: LCC
Horizontal Meridian: MGA
Vertical Level Datum: AHD D
Level Origin: PM107142(RL39.078)
Scale: 1:250 @ A1
Surveyed: HA
Designed: COLLIER'S
Drawn: JMc
Checked: JMc
Plot Date: 16 Dec, 2024
Computer File Ref: 430109-13061-ASW01-B LOCAL.dwg

AS-CONSTRUCTED
STORMWATER

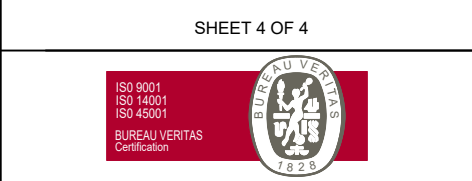

veris
BRISBANE (07) 3666 4700 WHITSUNDAYS (07) 4945 6600
MACKAY (07) 4951 9100 CAIRNS (07) 4222 9400
veris.com.au
ACN 615 735 727
Veris Australia Pty Ltd

Drawing No 430109-13061-ASW01 B Issue

Consulting Engineer's Certification.

I, hereby certify that the As Constructed information shown on this plan is a true and correct record of the sizes, types, materials, classes etc., and it corresponds with the relevant approved Engineering Drawings.

Signed..... RPEQ No Dated.....

Registered Surveyor's Certification.

We, VERIS AUSTRALIA P/L hereby certify that the horizontal and vertical locations, and dimensions shown on this plan are a true and correct record of the As Constructed information.

Signed..... Cadastral Surveyor Reg. No. 6448
Dated..... & Delegate
Veris Australia Pty Ltd