

Consulting Engineer's Certification.
 I, **Dan Collins**, hereby certify that the As Constructed information shown on this plan is a true and correct record of the sizes, types, materials, classes etc., and it corresponds with the relevant approved Engineering Drawings.
 Signed: _____ RPEQ No. 18631 Dated: 18/04/2024

REGISTERED SURVEYOR'S CERTIFICATION
 We, **Veris Australia Pty Ltd**, hereby certify that the vertical and horizontal locations and dimensions shown on this plan are a true and correct record and were located by survey.
 Delegate Cadastral Surveyor (sig.) Reg. Surveyor No. 6448 Date: 18/04/2024

FLAGSTONE STAGE 5M
 For **PEET FLAGSTONE CITY PTY LTD**

IMPORTANT NOTES:
 This Plan has been prepared for PEET FLAGSTONE CITY PTY LTD to Logan City standards, for the purpose of recording the As Constructed details of a new service constructed under a specific Council Approval and should not be used for any other purpose.
 No report is made on any other services, nor any services that may exist before or be constructed after, the time of survey, or constructed under any other approval.
 The property boundaries, easements and lot numbers shown herein may be proposed only and subject to registration by the Department of Natural Resources. All property information should be determined from the registered Survey Plans.
 All dimensions should be verified and confirmed against the latest information prior to commencement by any person using this plan for building purposes.
 Veris Australia Pty Ltd accepts no responsibility for any changes made to construction or otherwise, after the date of this plan. Any discrepancies should be clarified in writing with the relevant Authority prior to commencement of the work.
 Copyright © Veris Australia Pty Ltd, September 2023.

THESE DESIGNS AND DRAWINGS ARE COPYRIGHT AND ARE NOT TO BE USED OR REPRODUCED WITHOUT THE WRITTEN PERMISSION OF VERIS

Data Sources: 30109-L-Master(D0) FS94 2014.dwg
 Cadastral Boundaries: _____
 As-on survey: Veris
 Engineering Design: Colliers

Issue	Revisions	Date	Drawn
F	Current SL on R & Round HC SL	16.2.2024	JMc
E	Progress Plot	15.2.2024	JMc
D	Progress Plot	14.12.2023	JMc
C	Progress Plot	07.12.2023	JMc
B	Progress Plot	19.10.2023	JMc
A	Progress Plot	15.09.2023	JMc


Local Authority: LCC
 Horizontal Meridian: MGA
 Vertical Level Datum: AHD D
 Level Origin: PM107142(RL39.078)
 Scale: 1:250 @ A1
 Surveyed: HA
 Designed: Colliers
 Drawn: JMc
 Checked: JMc
 Plot Date: 16 Feb, 2024
 Computer File Ref: 430109-15131-AS01-F-LOCAL FS94.dwg



AS-CONSTRUCTED SEWER

SHEET 1 OF 1

veris
 BRISBANE WHITSUNDAYS
 (07) 3666 4700 (07) 4945 8600
 MACKAY CAIRNS
 (07) 4957 9100 (07) 4222 9400
 veris.com.au
 ACN 615 735 727
 Veris Australia Pty Ltd

Drawing No: 430109-15131-AS01 Issue: F

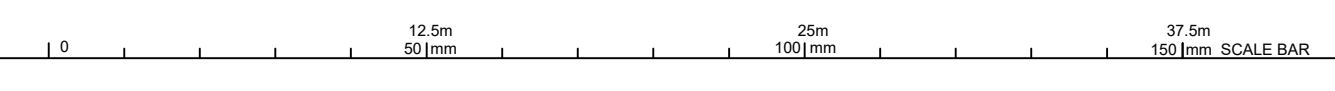

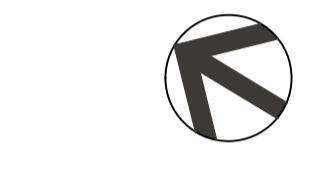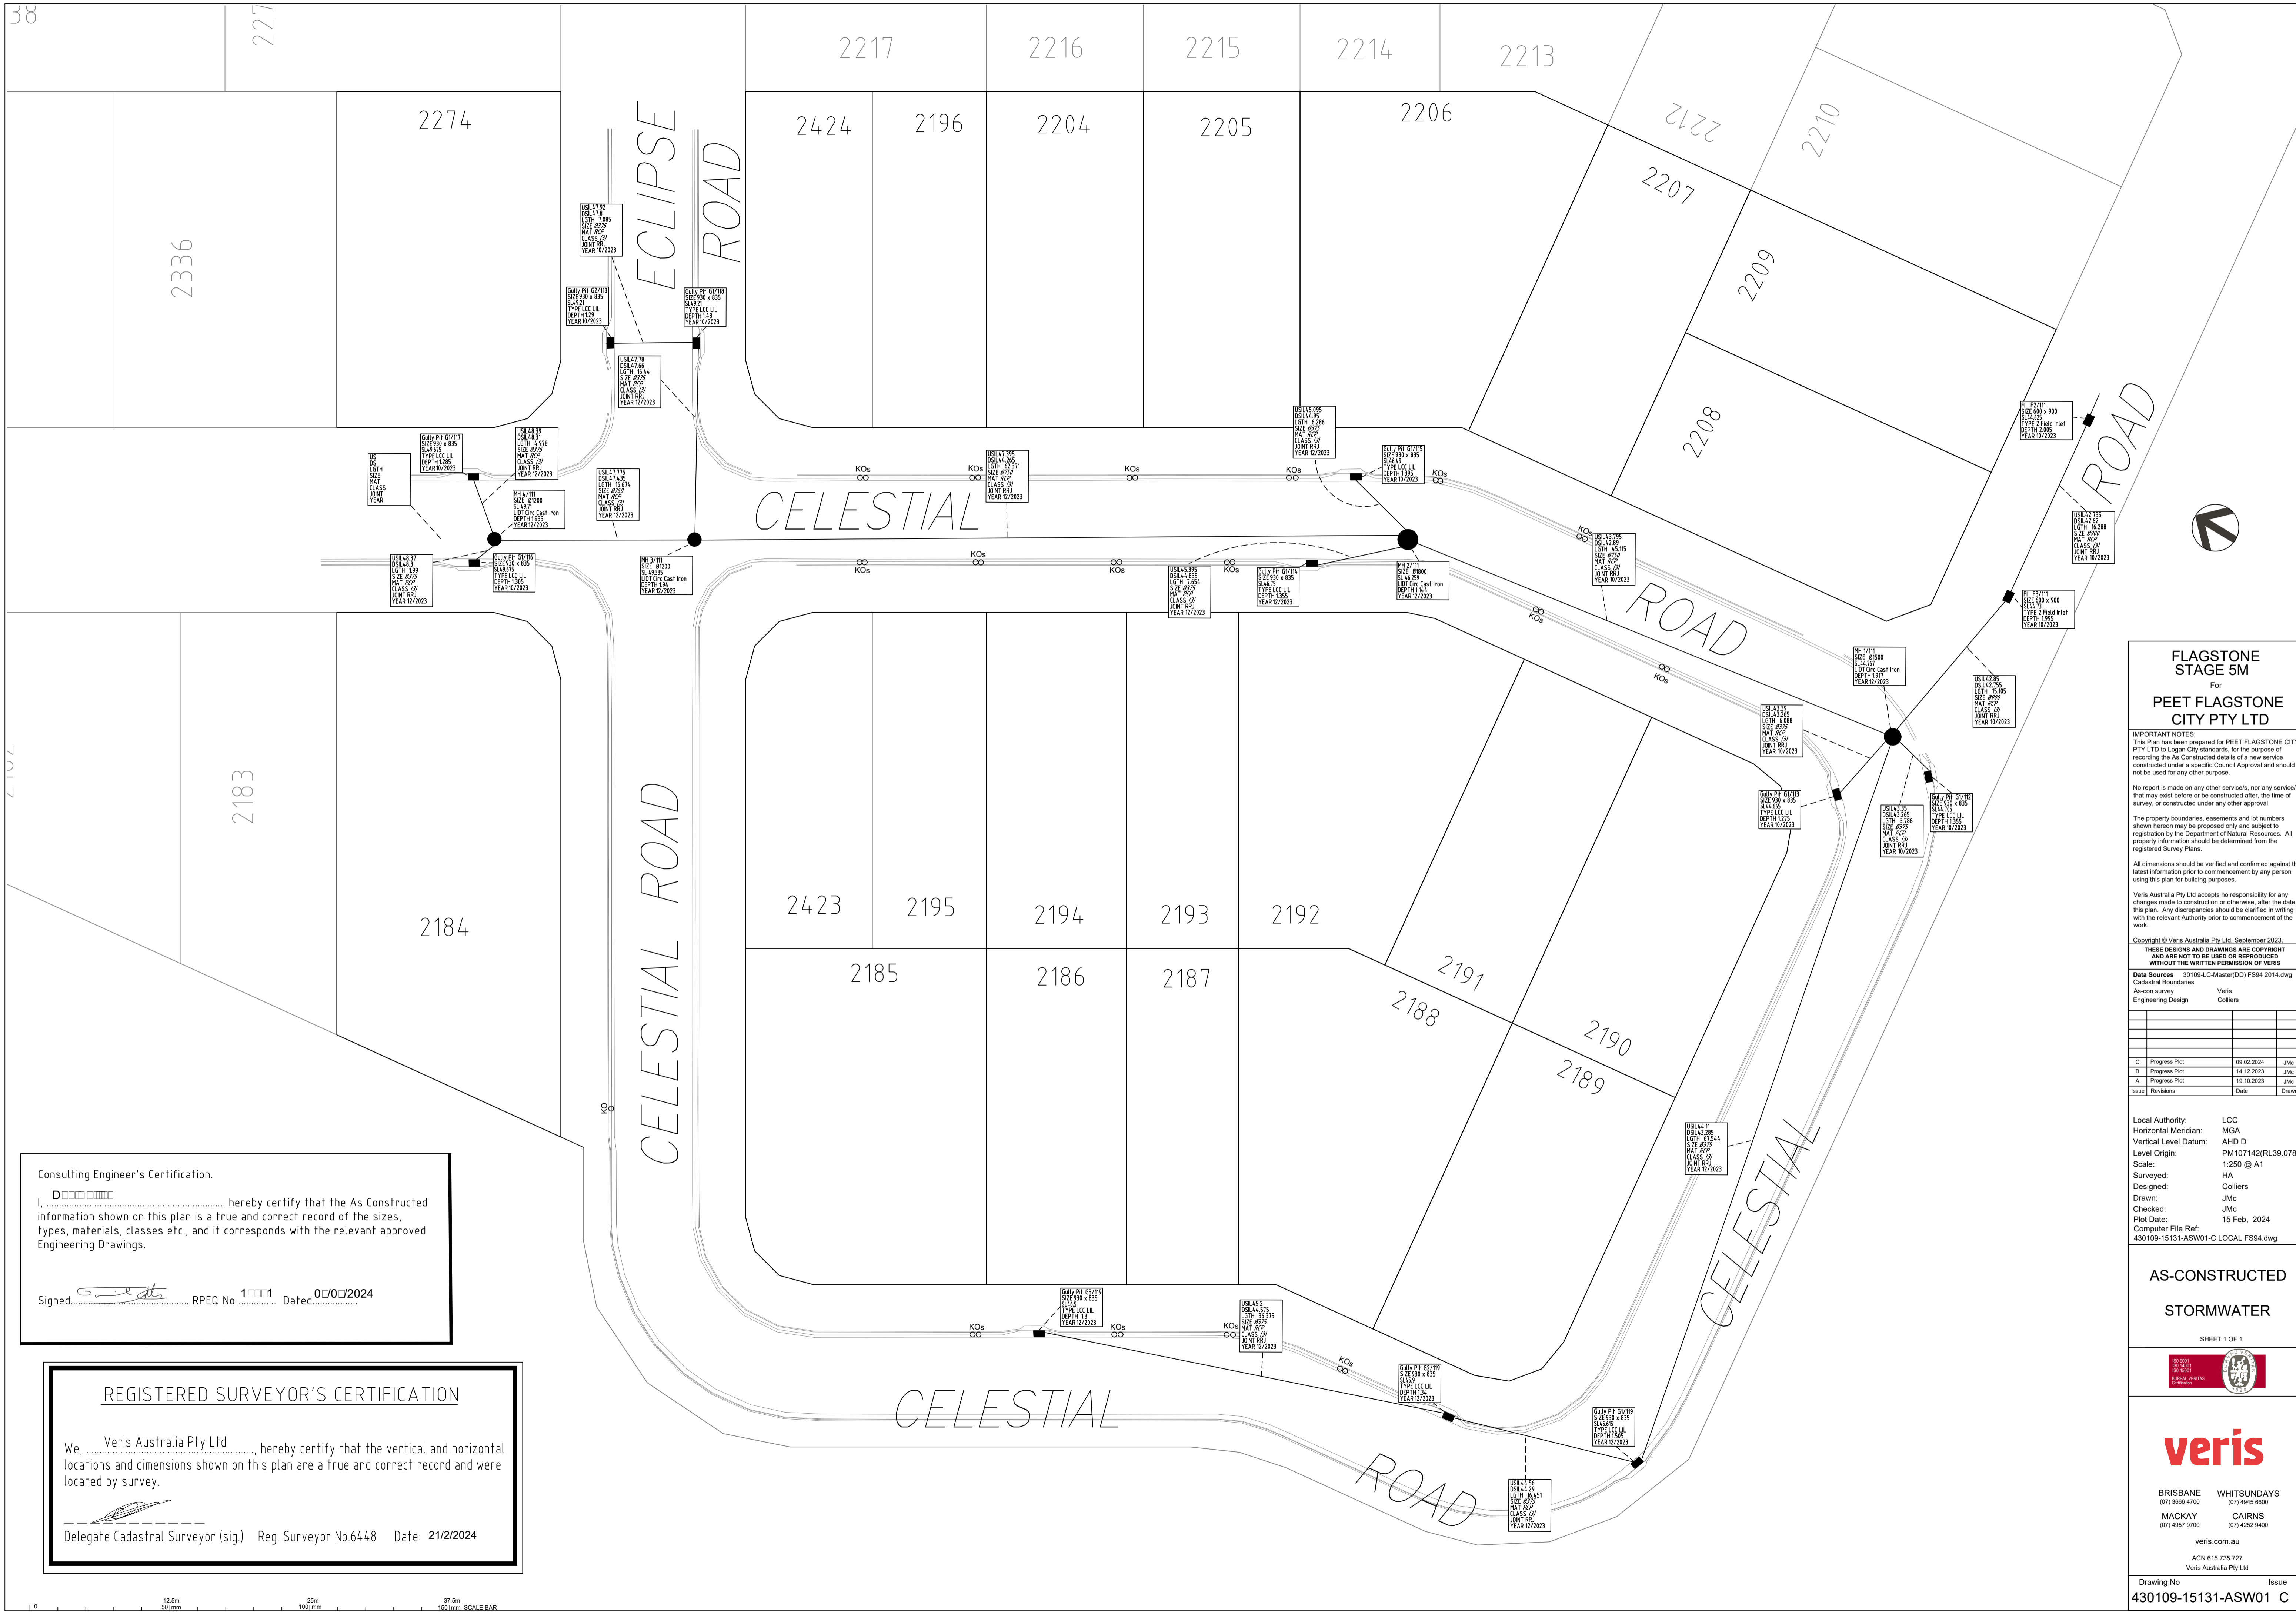

**FLAGSTONE
STAGE 5M**
For
**PEET FLAGSTONE
CITY PTY LTD**

IMPORTANT NOTES:
This Plan has been prepared for PEET FLAGSTONE CITY PTY LTD to Logan City standards, for the purpose of recording the As Constructed details of a new service constructed under a specific Council Approval and should not be used for any other purpose.
No report is made on any other services, nor any services that may exist before or be constructed after, the time of survey, or constructed under any other approval.
The property boundaries, easements and lot numbers shown herein may be proposed only and subject to registration by the Department of Natural Resources. All property information should be determined from the registered Survey Plans.
All dimensions should be verified and confirmed against the latest information prior to commencement by any person using this plan for building purposes.
Veris Australia Pty Ltd accepts no responsibility for any changes made to construction or otherwise, after the date of this plan. Any discrepancies should be clarified in writing with the relevant Authority prior to commencement of the work.


Copyright © Veris Australia Pty Ltd. September 2023.

THESE DESIGNS AND DRAWINGS ARE COPYRIGHT AND ARE NOT TO BE USED OR REPRODUCED WITHOUT THE WRITTEN PERMISSION OF VERIS

Revision	Date	Drawn
C	09.02.2024	JMc
B	14.12.2023	JMc
A	19.10.2023	JMc

Local Authority: LCC
Horizontal Meridian: MGA
Vertical Level Datum: AHD D
Level Origin: PM107142(RL39.078)
Scale: 1:250 @ A1
Surveyed: HA
Designed: Colliers
Drawn: JMc
Checked: JMc
Plot Date: 15 Feb, 2024
Computer File Ref: 430109-15131-ASW01-C LOCAL.FS94.dwg

**AS-CONSTRUCTED
STORMWATER**

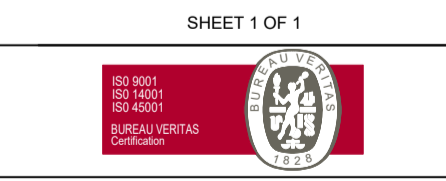


veris


BRISBANE WHITSUNDAYS
(07) 3660 4700 (07) 4945 6600
MACKAY CAIRNS
(07) 4957 9700 (07) 4222 9400

veris.com.au
ACN 615 735 727
Veris Australia Pty Ltd

Consulting Engineer's Certification.
I, Dimitrios Dimitriadis hereby certify that the As Constructed information shown on this plan is a true and correct record of the sizes, types, materials, classes etc., and it corresponds with the relevant approved Engineering Drawings.
Signed Dimitrios Dimitriadis RPEQ No. 10001 Dated 07/02/2024

REGISTERED SURVEYOR'S CERTIFICATION
We, Veris Australia Pty Ltd hereby certify that the vertical and horizontal locations and dimensions shown on this plan are a true and correct record and were located by survey.
Delegate Cadastral Surveyor (Sig.) Reg. Surveyor No.6448 Date: 21/2/2024

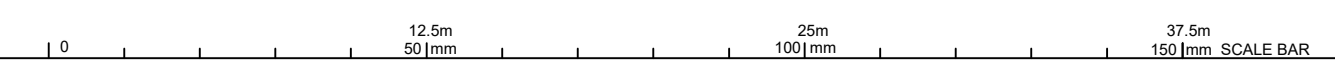

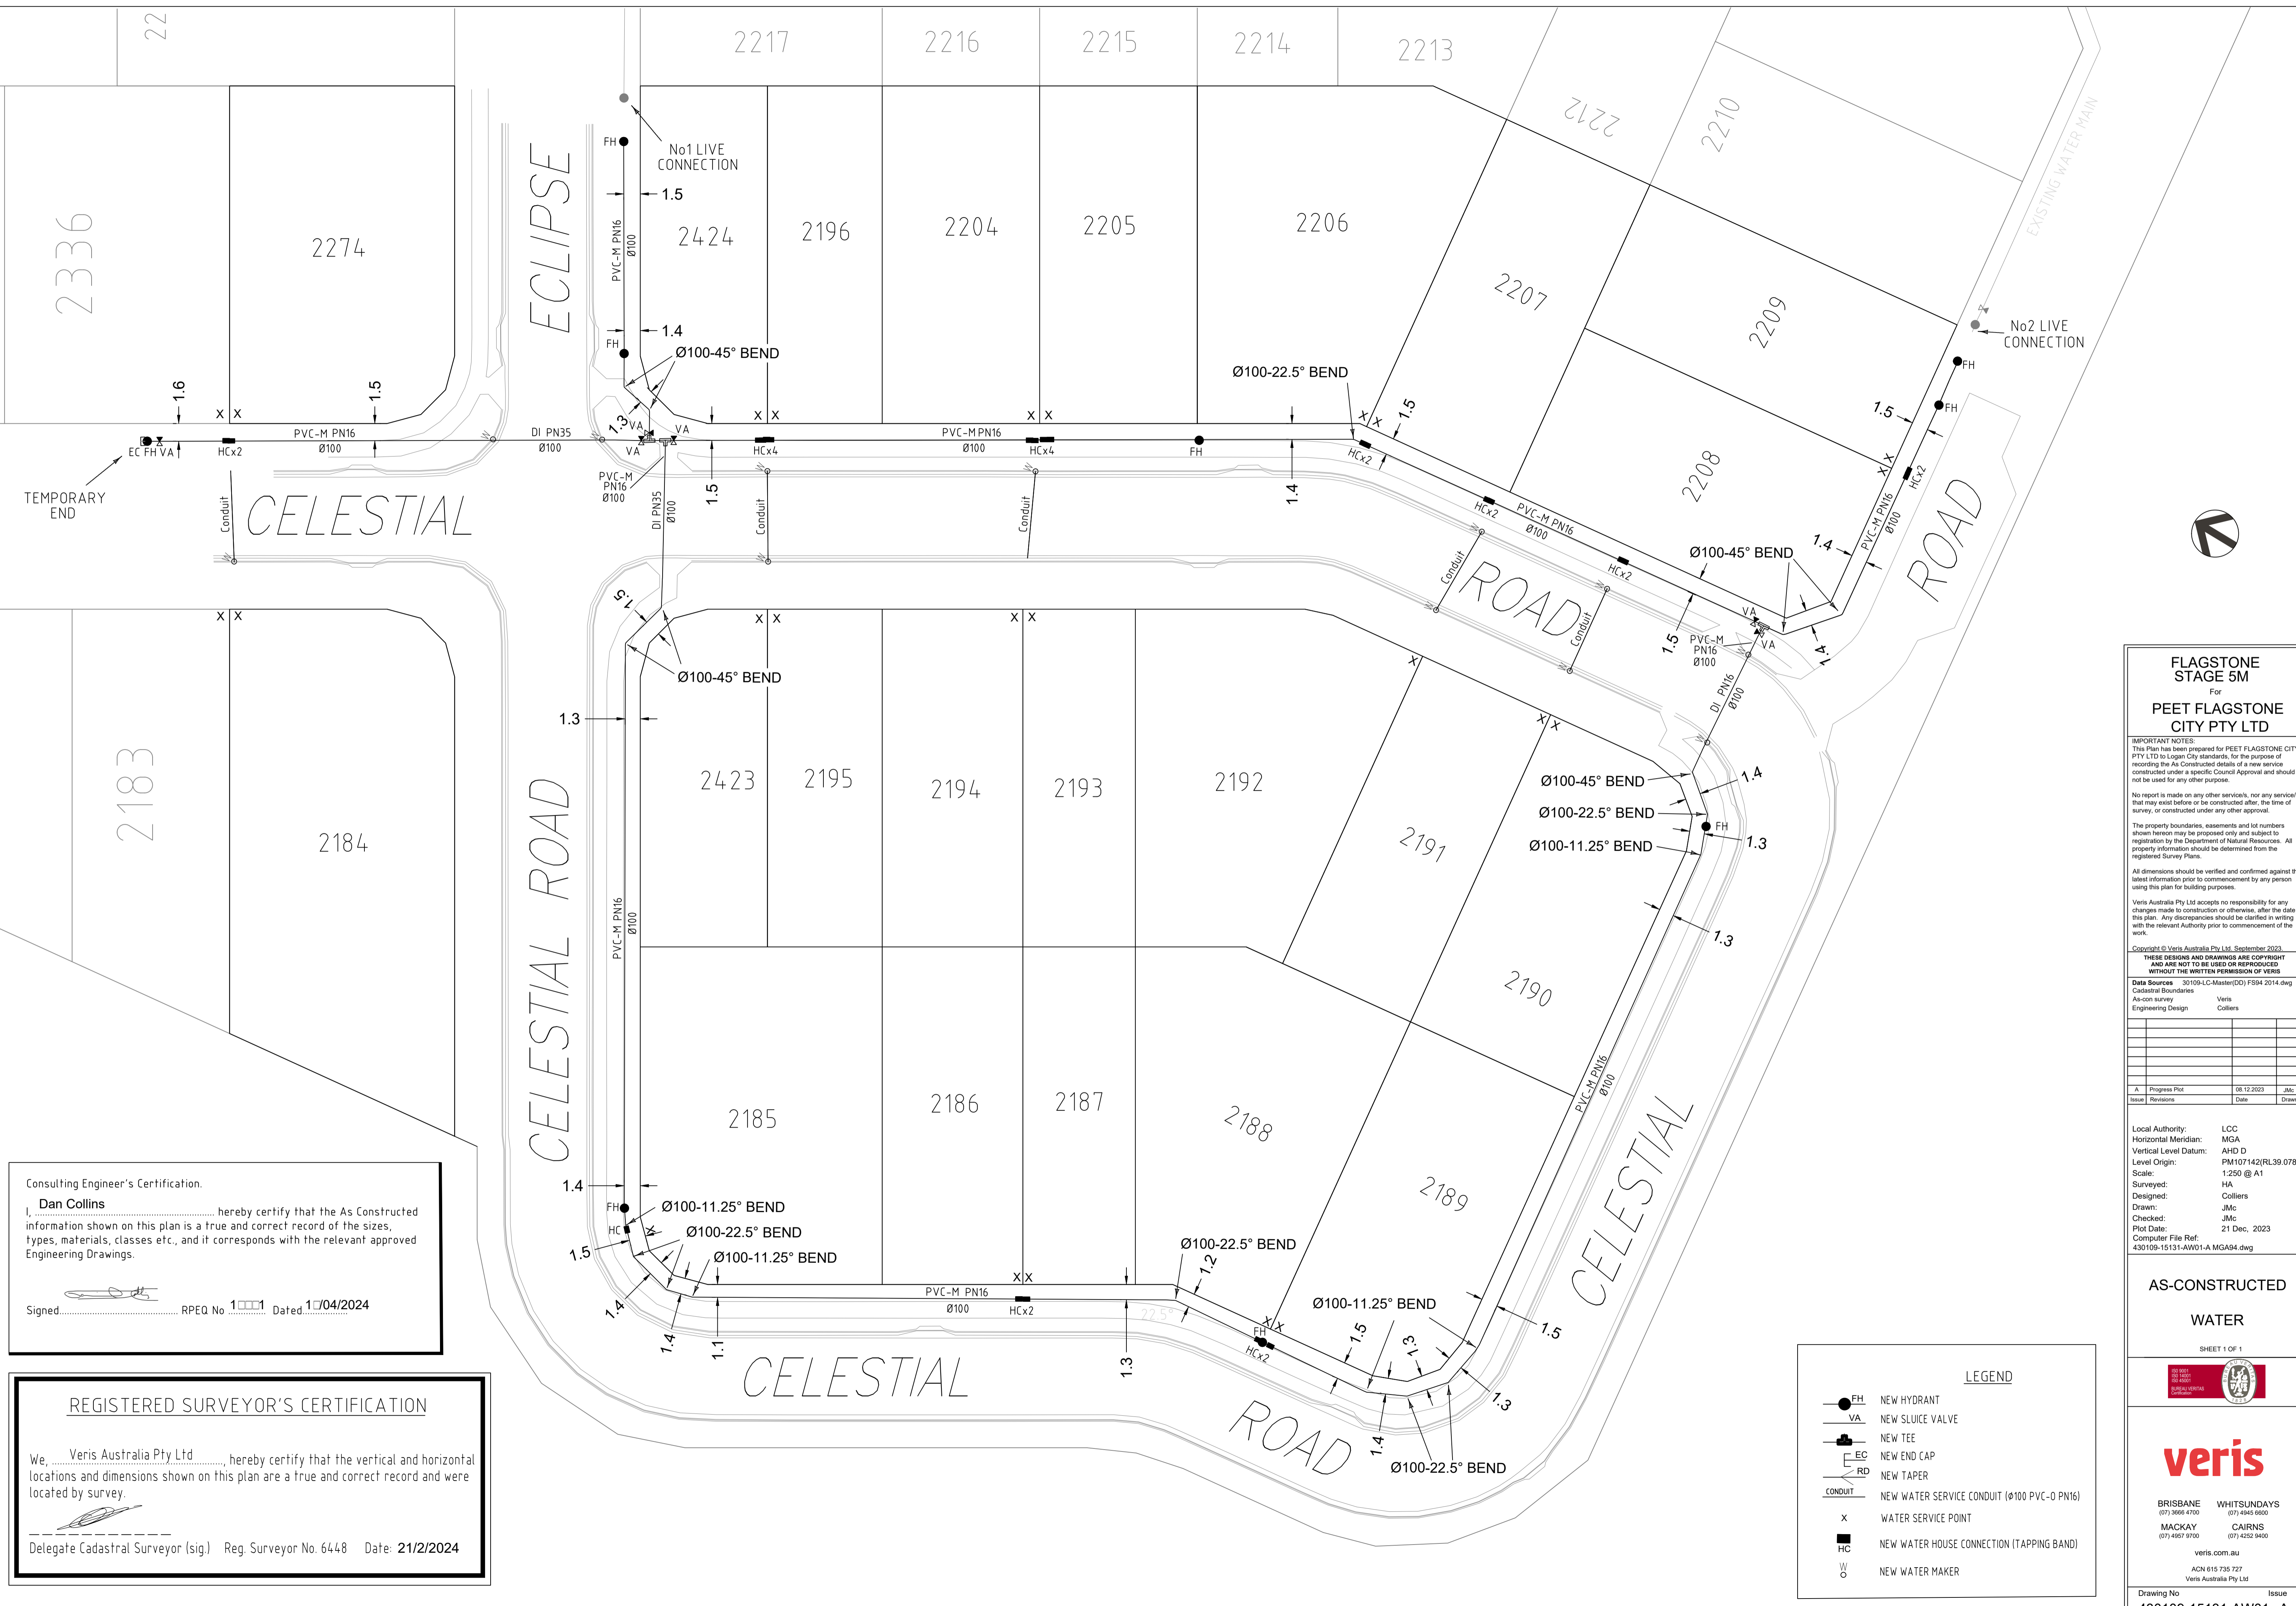

Consulting Engineer's Certification.
 I, **Dan Collins**, hereby certify that the As Constructed information shown on this plan is a true and correct record of the sizes, types, materials, classes etc., and it corresponds with the relevant approved Engineering Drawings.

Signed: RPEQ No. 1011 Dated: 10/04/2024

REGISTERED SURVEYOR'S CERTIFICATION

We, **Veris Australia Pty Ltd**, hereby certify that the vertical and horizontal locations and dimensions shown on this plan are a true and correct record and were located by survey.

Delegate Cadastral Surveyor (sig.) Reg. Surveyor No. 6448 Date: 21/2/2024

FLAGSTONE STAGE 5M
 For **PEET FLAGSTONE CITY PTY LTD**

IMPORTANT NOTES:
 This Plan has been prepared for PEET FLAGSTONE CITY PTY LTD to Logan City standards, for the purpose of recording the As Constructed details of a new service constructed under a specific Council Approval and should not be used for any other purpose.

No report is made on any other services, nor any services that may exist before or be constructed after, the time of survey, or constructed under any other approval.

The property boundaries, easements and lot numbers shown hereon may be proposed only and subject to registration by the Department of Natural Resources. All property information should be determined from the registered Survey Plans.

All dimensions should be verified and confirmed against the latest information prior to commencement by any person using this plan for building purposes.

Veris Australia Pty Ltd accepts no responsibility for any changes made to construction or otherwise, after the date of this plan. Any discrepancies should be clarified in writing with the relevant Authority prior to commencement of the work.

Copyright © Veris Australia Pty Ltd, September 2023.

THESE DESIGNS AND DRAWINGS ARE COPYRIGHT AND ARE NOT TO BE USED OR REPRODUCED WITHOUT THE WRITTEN PERMISSION OF VERIS

Data Sources: 30109-LC-Master(DO) F594 2014.dwg
 Cadastral Boundaries: Veris
 As-on survey: Veris
 Engineering Design: Colliers

A	Progress Plot	08.12.2023	JMc
Issue	Revisions	Date	Drawn

Local Authority: LCC
 Horizontal Meridian: MGA
 Vertical Level Datum: AHD D
 Level Origin: PM107142(RL39.078)
 Scale: 1:250 @ A1
 Surveyed: HA
 Designed: Colliers
 Drawn: JMc
 Checked: JMc
 Plot Date: 21 Dec, 2023
 Computer File Ref: 430109-15131-AW01-A-MGA94.dwg

AS-CONSTRUCTED
WATER

SHEET 1 OF 1

veris

BRISBANE (07) 3069 6700 WHITSUNDAYS (07) 4945 6600
 MACKAY (07) 4927 9700 CAIRNS (07) 4532 9400

veris.com.au
 ACN 615 735 727
 Veris Australia Pty Ltd

Drawing No: 430109-15131-AW01 A Issue: A

LEGEND

- NEW HYDRANT
- NEW SLUICE VALVE
- NEW TEE
- NEW END CAP
- NEW TAPER
- NEW WATER SERVICE CONDUIT (Ø100 PVC-O PN16)
- WATER SERVICE POINT
- NEW WATER HOUSE CONNECTION (TAPPING BAND)
- NEW WATER MAKER





FLAGSTONE STAGE 5M
For
PEET FLAGSTONE CITY PTY LTD


IMPORTANT NOTES:
This Plan has been prepared for PEET FLAGSTONE CITY PTY LTD to Logan City standards, for the purpose of recording the As Constructed details of a new service constructed under a specific Council Approval and should not be used for any other purpose.
No report is made on any other services, nor any services that may exist before or be constructed after, the time of survey, or constructed under any other approval.
The property boundaries, easements and lot numbers shown herein may be proposed only and subject to registration by the Department of Natural Resources. All property information should be determined from the registered Survey Plans.
All dimensions should be verified and confirmed against the latest information prior to commencement by any person using this plan for building purposes.
Veris Australia Pty Ltd accepts no responsibility for any changes made to construction or otherwise, after the date of this plan. Any discrepancies should be clarified in writing with the relevant Authority prior to commencement of the work.

Copyright © Veris Australia Pty Ltd April 2024
THESE DESIGNS AND DRAWINGS ARE COPYRIGHT AND ARE NOT TO BE USED OR REPRODUCED WITHOUT THE WRITTEN PERMISSION OF VERIS
Data Sources: 30109.LC.Master(D) FS94 2014.dwg
Cadastral Boundaries
As-con survey Veris
Engineering Design Colliers


Issue	Revisions	Date	Drawn
A	Progress Plot	09.04.2024	JMc


Local Authority: LCC
Horizontal Meridian: MGA
Vertical Level Datum: AHD D
Level Origin: PM107142(RL39.078)
Scale: 1:250 @ A1
Surveyed: HA
Designed: Colliers
Drawn: JMc
Checked: JMc
Plot Date: 09 Apr, 2024
Computer File Ref: 430109-15131-AFS01-A-LOCAL-FS94.dwg

AS-CONSTRUCTED FINAL SURFACE

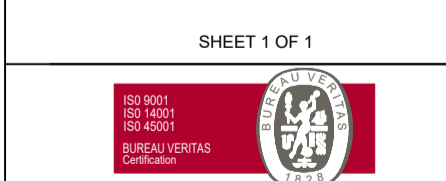

veris
BRISBANE (07) 3666 4700 WHITSUNDAYS (07) 4945 6600
MACKAY (07) 4967 9700 CAIRNS (07) 4252 9400
veris.com.au
ACN 615 735 727
Veris Australia Pty Ltd
Drawing No Issue
430109-15131-AFS01 A

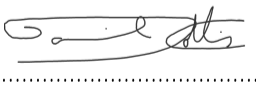Consulting Engineer's Certification.
I, **Dan Collins**, hereby certify that the As Constructed information shown on this plan is a true and correct record of the sizes, types, materials, classes etc., and it corresponds with the relevant approved Engineering Drawings.
Signed:  RPEQ No 18631 Dated 07/05/2024

REGISTERED SURVEYOR'S CERTIFICATION
We, **Veris Australia Pty Ltd**, hereby certify that the vertical and horizontal locations and dimensions shown on this plan are a true and correct record and were located by survey.

Delegate Cadastral Surveyor (sig.) Reg. Surveyor No. 6448 Date: 18/04/2024

LEGEND

50.25 ——— AS CONSTRUCTED CONTOURS (Interval 0.25m)

————— RETAINING WALL

